

Prentiss  
E 36  
8-20-70

MISSISSIPPI  
BOARD OF WATER COMMISSIONERS  
416 North State Street  
Jackson, Mississippi 39201

**CODED**

WATER WELL DRILLERS LOG

8-20 1970 Bond Well Drilling Prentiss  
date well completed firm name county well located

LANDOWNER: Earl Womack

description of formations encountered	from	to
---------------------------------------	------	----

Bonnaville Miss  
(mailing address)

Metal pipe	0	18
Triged sand	18	100
Blue clay	110	140
Water sand	140	190

WELL LOCATION:  
sec. 14 T 5 N R 6 E  
4 miles West of Bonnaville  
(distance) (direction) (nearest town)

WELL PURPOSE: Home  
(home, irrigation, municipal, industrial)

WELL COMPLETION DATA:

- (1) diameter (inches) 4
- (2) total depth (feet) 190
- (3) static water level (feet) 40 <sup>below</sup> <sub>above</sub> top of ground.
- (4) casing Steel 17.6  
(material) (depth)
- \_\_\_\_\_ if telescope see back.  
(size)
- (5) screen none  
(length) (depth to top)
- \_\_\_\_\_ (size) \_\_\_\_\_ (material)
- (6) pump \_\_\_\_\_ (HP) \_\_\_\_\_ (yield gpm)  
None on pump  
(type power)
- (7) electric log no  
(yes or no)
- \_\_\_\_\_ (organization running log)
- (8) how well bottom plugged \_\_\_\_\_


**CODED**

DRILLERS REMARKS:

SFP 9 1970

If well telescopes please sketch and show depths.

GROUND LEVEL

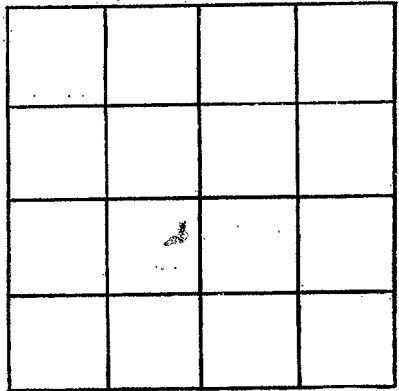

SECTION \_\_\_\_\_

Please indicate well location X.

ADDITIONAL INFORMATION

A series of horizontal lines for recording additional information, starting below the 'ADDITIONAL INFORMATION' header and extending to the bottom of the page.

If more than one screen, show locations of each on sketch.