

Prentiss
E 37
6-3-70

MISSISSIPPI
 BOARD OF WATER COMMISSIONERS
 416 North State Street
 Jackson, Mississippi 39201

CODED

WATER WELL DRILLERS LOG

6-3 date well completed 70 Bond W. Drilling Prentiss firm name county well located

LANDOWNER: Roy Waldron
Brownsville Miss.
 (mailing address)

description of formations encountered	from	to
<u>Red Clay</u>	<u>0</u>	<u>16</u>
<u>blue clay</u>	<u>16</u>	<u>110</u>
<u>water table</u>	<u>110</u>	<u>160</u>

WELL LOCATION:
 sec. 11 T 5 N R 6 E
5 miles S-W of Brownsville
 (distance) (direction) (nearest town)

WELL PURPOSE: Home
 (home, irrigation, municipal, industrial)

- WELL COMPLETION DATA:
- (1) diameter (inches) 4
 - (2) total depth (feet) 160
 - (3) static water level (feet) 58 below/above top of ground.
 - (4) casing Steel 21
 (material) (depth)
 (size) if telescope see back.
 - (5) screen None
 (length) (depth to top)
 (size) (material)
 - (6) pump 3/4 4
 (HP) (yield gpm)
Electric
 (type power)
 - (7) electric log no
 (yes or no)
 (organization running log)
 - (8) how well bottom plugged Open

CODED


DRILLERS REMARKS:

JUL 7 1970

MISS. BD. OF
 WATER COMM.

If well telescopes please sketch and show depths.

GROUND LEVEL

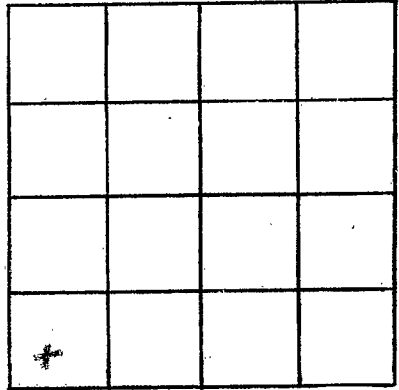

SECTION _____

Please indicate well location X.

ADDITIONAL INFORMATION

If more than one screen, show locations of each on sketch.