

PRENTISS
E 38
9-1-70

MISSISSIPPI
BOARD OF WATER COMMISSIONERS
416 North State Street
Jackson, Mississippi 39201

CODED

WATER WELL DRILLERS LOG

9-1 1970 Bonch Well Drilling Prentiss
date well completed firm name county well located

LANDOWNER: Charles Towell
Bromerville Miss
(mailing address)

description of formations encountered	from	to
<u>Imped clay</u>	<u>0</u>	<u>16</u>
<u>Blue clay</u>	<u>16</u>	<u>67</u>
<u>Water sand</u>	<u>67</u>	<u>115</u>

WELL LOCATION:
sec. 35 T. 5 N R. 6 E
6 miles West of Bromerville
(distance) (direction) (nearest town)

WELL PURPOSE: Home
(home, irrigation, municipal, industrial)

- WELL COMPLETION DATA:
- (1) diameter (inches) 4
 - (2) total depth (feet) 115
 - (3) static water level (feet) 18 below top of ground.
 - (4) casing Steel 21
(material) (depth)
 if telescope see back.
(size)
 - (5) screen None
(length) (depth to top)
 (size) (material)
 - (6) pump 3/4 8
(HP) (yield gpm)
Elect jet
(type power)
 - (7) electric log no
(yes or no)
 (organization running log)
 - (8) how well bottom plugged open

CODED


OCT 12 1970

DRILLERS REMARKS:

MISS. BD. OF
WATER
COMMISSIONERS

If well telescopes please sketch and show depths.

GROUND LEVEL

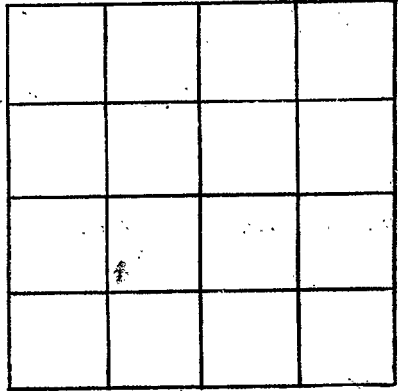

SECTION _____

Please indicate well location X.

ADDITIONAL INFORMATION

If more than one screen, show locations of each on sketch.