

PRENTISS  
E 39  
9-1-70

MISSISSIPPI  
BOARD OF WATER COMMISSIONERS  
416 North State Street  
Jackson, Mississippi 39201

**CODED**

WATER WELL DRILLERS LOG

9-1 date well completed 1970 Bonds Well Drilling, Prentiss firm name county well located

LANDOWNER: <u>Charles Lovell</u>	description of formations encountered	from	to
<u>Brownville Miss.</u> (mailing address)	<u>Medial clay</u>	<u>0</u>	<u>16</u>
	<u>Blue clay</u>	<u>16</u>	<u>56</u>
	<u>Water sand</u>	<u>56</u>	<u>100</u>
<b>WELL LOCATION:</b>			
sec. <u>35</u> T <u>5</u> N R <u>6</u> E <u>6</u> miles <u>West</u> of <u>Brownville</u> (distance) (direction) (nearest town)			
<b>WELL PURPOSE:</b> <u>Home</u> (home, irrigation, municipal, industrial)			
<b>WELL COMPLETION DATA:</b>			
(1) diameter (inches) <u>4</u>			
(2) total depth (feet) <u>100</u>			
(3) static water level (feet) <u>16 ft</u> below top of ground.			
(4) casing <u>Steel</u> <u>21</u> (material) (depth)			
_____ if telescope see back. (size)			
(5) screen <u>none</u> (length) (depth to top)			
_____ (size) _____ (material)			
(6) pump <u>3/4</u> <u>5</u> (HP) (yield gpm)			
<u>Electric</u> (type power)			
(7) electric log <u>no</u> (yes or no)			
_____ (organization running log)			
(8) how well bottom plugged <u>open</u>			
<b>DRILLERS REMARKS:</b>			


**CODED**

OCT 12 1970

MISS. BD. OF  
WATER COMM.

If well telescopes please sketch and show depths.

GROUND LEVEL

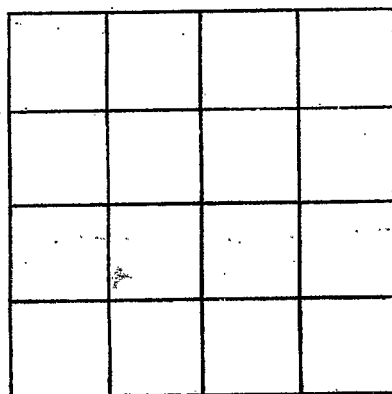

SECTION \_\_\_\_\_

Please indicate well location X.

ADDITIONAL INFORMATION

If more than one screen,  
show locations of each on sketch.