

PRENTISS
E 41
9-9-70

MISSISSIPPI
BOARD OF WATER COMMISSIONERS
416 North State Street
Jackson, Mississippi 39201

CODED

WATER WELL DRILLERS LOG

9-9 1970 Bonnet Well Drilling, Prentiss
date well completed firm name county well located

LANDOWNER: Raymond Lee Lindsey
Bonneville Miss
(mailing address)

description of formations encountered	from	to
	Red clay	0
Blue clay	15	173
Water sand	173	220

WELL LOCATION:
sec. 16 T 5 N R. 6 E
4 1/2 miles West of Bonneville
(distance) (direction) (nearest town)

CODED

WELL PURPOSE: Home
(home, irrigation, municipal, industrial)

- WELL COMPLETION DATA:
- (1) diameter (inches) 4
 - (2) total depth (feet) 220
 - (3) static water level (feet) 165 below top of ground.
 - (4) casing Steel, 21
(material) (depth)
 if telescope see back.
(size)
 - (5) screen None
(length) (depth to top)
 (size) (material)
 - (6) pump (HP) (yield gpm)
Hand on pump
(type power)
 - (7) electric log No
(yes or no)
 (organization running log)
 - (8) how well bottom plugged Open


OCT 12 1970

DRILLERS REMARKS:

MISS. BD. OF
WATER COMM.

If well telescopes please sketch and show depths.

GROUND LEVEL

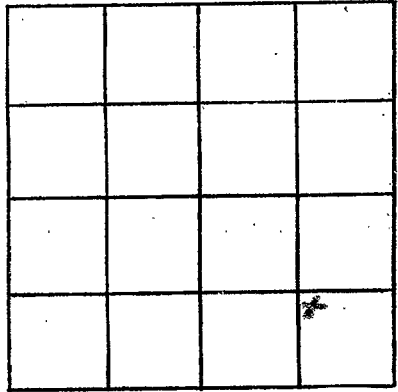

SECTION _____

Please indicate well location X.

ADDITIONAL INFORMATION

If more than one screen,
show locations of each on sketch.