

PRENTISS  
E 42  
7-17-70

MISSISSIPPI  
BOARD OF WATER COMMISSIONERS  
416 North State Street  
Jackson, Mississippi 39201

**CODED**

WATER WELL DRILLERS LOG

7-17 1970 Bond Well Drilling Prentiss  
date well completed firm name county well located

LANDOWNER: Glen Smith  
Booneville Miss.  
(mailing address)

| description of formations encountered | from | to  |
|---------------------------------------|------|-----|
| Red clay                              | 0    | 16  |
| blue clay                             | 16   | 147 |
| Water sand                            | 147  | 200 |

WELL LOCATION:  
sec 3 T 5 N R 6 E  
7 miles West of Booneville  
(distance) (direction) (nearest town)

WELL PURPOSE: Home  
(home, irrigation, municipal, industrial)

- WELL COMPLETION DATA:
- (1) diameter (inches) 4
  - (2) total depth (feet) 200
  - (3) static water level (feet) 80 below top of ground.
  - (4) casing Steel 21  
(material) (depth)
  - (size) If telescope see back.
  - (5) screen None  
(length) (depth to top)
  - (size) (material)
  - (6) pump 1 5  
(HP) (yield gpm)
  - Electric  
(type power)
  - (7) electric log no  
(yes or no)
  - (organization running log)
  - (8) how well bottom plugged open

**CODED**


DRILLERS REMARKS:

AUG 11 1970

CLASS. BY  
WATER

If well telescopes please sketch and show depths.

GROUND LEVEL

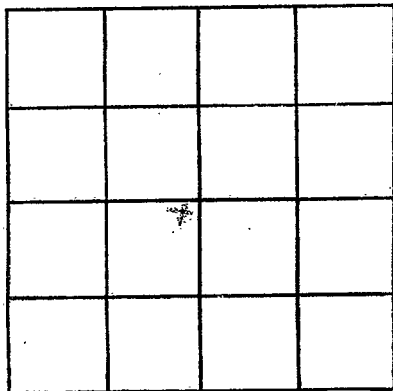

SECTION \_\_\_\_\_

Please indicate well location X.

ADDITIONAL INFORMATION

If more than one screen, show locations of each on sketch.