

PRENTISS
E 43
7-28-70

MISSISSIPPI
 BOARD OF WATER COMMISSIONERS
 416 North State Street
 Jackson, Mississippi 39201

CODED

WATER WELL DRILLERS LOG
 Herndon-Homan Well & Supply, Inc.

P. O. Box 42

Prentiss

7-28 19 70
 date well completed

PRENTISS county well located

LANDOWNER: Herman Ballard

description of formations encountered

from to

Route 2
Baldwyn, Miss.
 (mailing address)

Surface sand 0 18
Clay 18 160
Chalk clay 160 300
Sand 300
Gravel 300

WELL LOCATION:

sec. 28 T. 5 N. R. 6E
5 miles NW of Wheeler
 (distance) (direction) (nearest town)


WELL PURPOSE: Home
 (home, irrigation, municipal, industrial)

WELL COMPLETION DATA:

- (1) diameter (inches) 5"
- (2) total depth (feet) 300'
- (3) static water level (feet) 108 below top of ground.
- (4) casing Steel 21'
 (material) (depth)
5" if telescope see back.
 (size)
- (5) screen 70
 (length) (depth to top)
 (size) (material)
- (6) pump 1/3 5
 (HP) (yield gpm)
Electric
 (type power)
- (7) electric log no
 (yes or no)

(organization running log)

(8) how well bottom plugged open

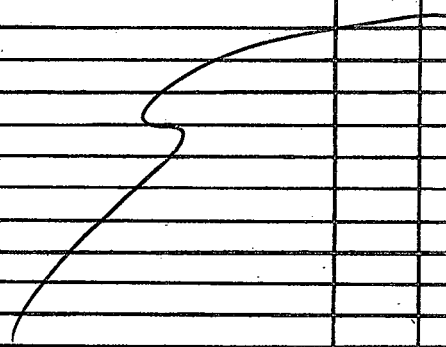

CODED


AUG 26 1970

DRILLERS REMARKS:

MISS. BD. OF
 WATER COMMISSIONERS

If well telescopes please sketch and show depths.

GROUND LEVEL

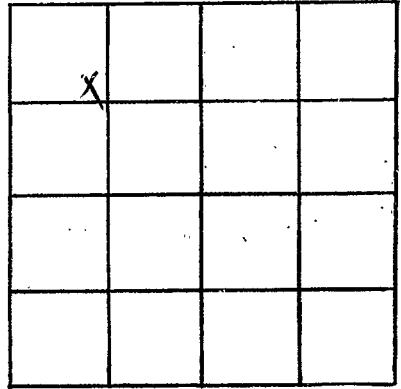

SECTION 28

Please indicate well location X.

ADDITIONAL INFORMATION

If more than one screen, show locations of each on sketch.