

PRENTISS
E 45
3-2-71

MISSISSIPPI
BOARD OF WATER COMMISSIONERS
416 North State Street
Jackson, Mississippi 39201

CODED

WATER WELL DRILLERS LOG

3-2-1971 date well completed
71 Bonds Well Drilling Prentiss firm name
county well located

LANDOWNER: Jou Bureau

description of formations encountered	from	to
<u>Red clay</u>	<u>0</u>	<u>38</u>
<u>blue clay</u>	<u>38</u>	<u>70</u>
<u>Water sand</u>	<u>70</u>	<u>118</u>

Bonnaville Min
(mailing address)

WELL LOCATION:
sec. 35 T. 5 N R. 6 E
6 miles West of Bonnaville
(distance) (direction) (nearest town)

WELL PURPOSE: Home
(home, irrigation, municipal, industrial)

WELL COMPLETION DATA:

- (1) diameter (inches) 4
- (2) total depth (feet) 118
- (3) static water level (feet) 26 below above top of ground.
- (4) casing Steel 142
(material) (depth)
- (size) If telescope see back.
- (5) screen None
(length) (depth to top)
- (size) (material)
- (6) pump 1/2 5
(HP) (yield gpm)
- Electric pump
(type power)
- (7) electric log no
(yes or no)
- (organization running log)
- (8) how well bottom plugged open

CODED


APR - 6 1971

MISS. BD. OF
WATER RESOURCES

DRILLERS REMARKS:

If well telescopes please sketch and show depths.

GROUND LEVEL

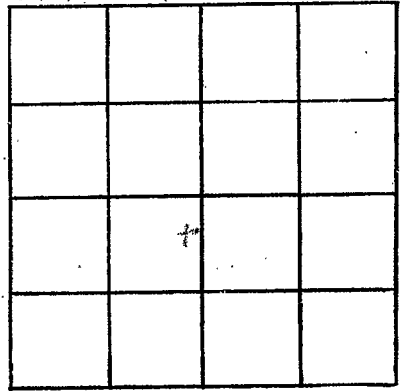

SECTION _____

Please indicate well location X.

ADDITIONAL INFORMATION

If more than one screen,
show locations of each on sketch.