

PRENTISS
E 46
3-18-71

MISSISSIPPI
BOARD OF WATER COMMISSIONERS
416 North State Street
Jackson, Mississippi 39201

CODED

WATER WELL DRILLERS LOG

3-18 date well completed 1971 Bond Well Drilling firm name Prentiss county well located

LANDOWNER: Charles Jewell
Brownville Miss
(mailing address)

description of formations encountered	from	to
Red clay	0	18
Blue clay	18	60
Water sand	60	110

WELL LOCATION:
sec. 35 T. 5 N. R. 6 E.
6 miles West of Brownville
(distance) (direction) (nearest town)

WELL PURPOSE: Home
(home, irrigation, municipal, industrial)

- WELL COMPLETION DATA:
- (1) diameter (inches) 4
 - (2) total depth (feet) 110
 - (3) static water level (feet) 16 ^{below} _{above} top of ground.
 - (4) casing Steel 21
(material) (depth)
(size) if telescope see back.
 - (5) screen none
(length) (depth to top)
(size) (material)
 - (6) pump 1/2 5
(HP) (yield gpm)
Electric pump
(type power)
 - (7) electric log no
(yes or no)
(organization running log)
 - (8) how well bottom plugged open

CODED


APR - 0. 1971

DRILLERS REMARKS:

MISS. BD. OF
WATER COMMISSIONERS

If well telescopes please sketch and show depths.

GROUND LEVEL

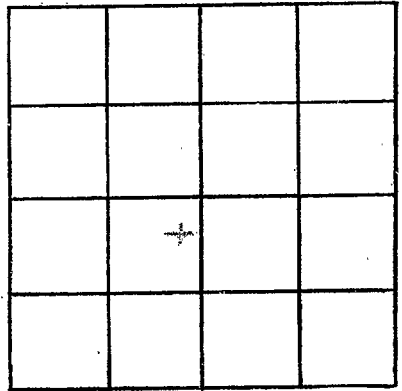

SECTION _____

Please indicate well location X.

ADDITIONAL INFORMATION

If more than one screen, show locations of each on sketch.