

PRENTISS
E 47
4-26-71

MISSISSIPPI
BOARD OF WATER COMMISSIONERS
416 North State Street
Jackson, Mississippi 39201

CODED

WATER WELL DRILLERS' LOG

4-26

1971

~~Bond's Well Drilling~~
~~Stratton~~

Prentiss

date well completed

firm name

county well located

LANDOWNER: Dorena M. Hayfield

description of formations encountered

from

to

Boonville Miss
(mailing address)

Red clay	0	12
Red and yellow sand	12	58
Blue clay	58	176
Water sand	176	220

WELL LOCATION:

sec. 28 T. 5 N R. 6 E
5 miles South of Boonville
(distance) (direction) (nearest town)

WELL PURPOSE: Home
(home, irrigation, municipal, industrial)

WELL COMPLETION DATA:

- (1) diameter (inches) 4
- (2) total depth (feet) 220
- (3) static water level (feet) 60 below above top of ground.
- (4) casing Steel 63
(material) (depth)
(size) If telescope see back.
- (5) screen None
(length) (depth to top)
(size) (material)
- (6) pump Had on pump
(HP) (yield gpm)
(type power)
- (7) electric log no
(yes or no)
(organization running log)
- (8) how well bottom plugged Open

CODED


DRILLERS REMARKS:

MAY 10 1971

MISS. BD. OF
WATER COMMISSIONERS

If well telescopes please sketch and show depths.

GROUND LEVEL

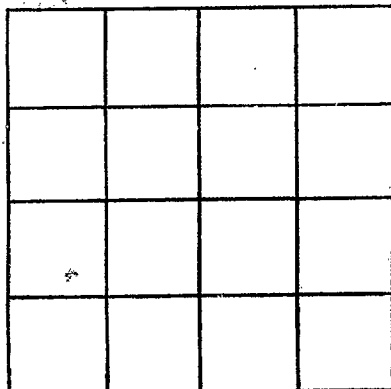

SECTION _____

Please indicate well location X.

ADDITIONAL INFORMATION

If more than one screen, show locations of each on sketch.