

PRENTISS

E48

4-27-71

MISSISSIPPI BOARD OF WATER COMMISSIONERS  
416 North State Street  
Jackson, Mississippi 39201

**CODED**

WATER WELL DRILLERS LOG

4-27

1971

Bond Well Drilling

Prentiss

date well completed

firm name

county well located

LANDOWNER: Charles Lovell

description of formations encountered

from

to

Booneville, Miss  
(mailing address)

Red clay  
blue clay  
water sand

0 39  
39 97  
97 150

WELL LOCATION:

sec 35 T 5 N R 6 E  
4 miles S.W. of Booneville  
(distance) (direction) (nearest town)

**CODED**

WELL PURPOSE: Home  
(home, irrigation, municipal, industrial)

WELL COMPLETION DATA:

- (1) diameter (inches) 4
- (2) total depth (feet) 150
- (3) static water level (feet) 15 below above top of ground.
- (4) casing Steel 42  
(material) (depth)
- \_\_\_\_\_ if telescope see back.  
(size)
- (5) screen none  
(length) (depth to top)
- \_\_\_\_\_ (size) \_\_\_\_\_ (material)
- (6) pump 1/2 5  
(HP) (yield gpm)
- electric  
(type power)
- (7) electric log no  
(yes or no)
- \_\_\_\_\_ (organization running log)
- (8) how well bottom plugged open


MAY 10 1971

DRILLERS REMARKS:

MISS. BD. OF  
WATER COMM.

If well telescopes please sketch and show depths.

GROUND LEVEL

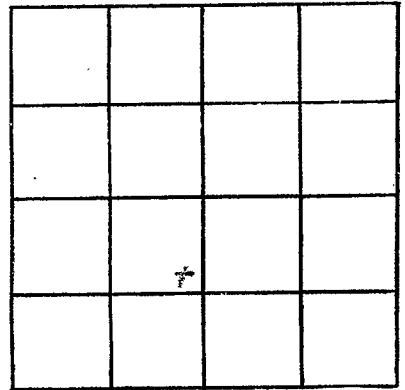

SECTION \_\_\_\_\_

Please indicate well location X.

ADDITIONAL INFORMATION

If more than one screen,  
show locations of each on sketch.