

PRENTISS

E 49

5-21-71

MISSISSIPPI BOARD OF WATER COMMISSIONERS  
416 North State Street  
Jackson, Mississippi 39201

**CODED**

WATER WELL DRILLERS LOG

5-21

1971 Bonds Well Drilling

Prentiss

date well completed

firm name

county well located

LANDOWNER: Walter Koston

description of formations encountered

from

to

Bronnells Mica  
(mailing address)

Red clay	0	23
Blue sand	23	58
Blue clay	58	104
Water sand	104	150

WELL LOCATION:

sec. 35 T-5 N R-6 E

5 miles West of Bronnells  
(distance) (direction) (nearest town)

WELL PURPOSE: None  
(home, irrigation, municipal, industrial)

WELL COMPLETION DATA:

- (1) diameter (inches) 4
- (2) total depth (feet) 150
- (3) static water level (feet) 60 below above top of ground.
- (4) casing Steel 63  
(material) (depth)

**CODED**

(size) If telescope see back.

- (5) screen None  
(length) (depth to top)

(size) (material)

- (6) pump 3/4 5  
(HP) (yield gpm)

Electric pump  
(type power)

- (7) electric log no  
(yes or no)

(organization running log)

- (8) how well bottom plugged open


JUN 4 1971

DRILLERS REMARKS:

MISS. BD. OF WATER COMMISSIONERS

If well telescopes please sketch and show depths.

GROUND LEVEL

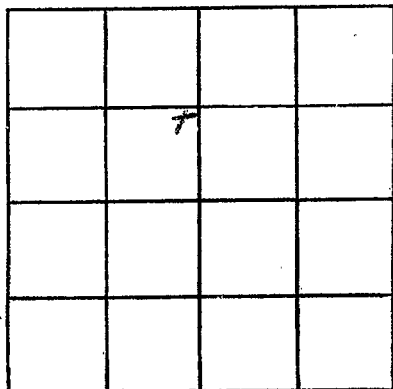

SECTION \_\_\_\_\_

Please indicate well location X.

ADDITIONAL INFORMATION

If more than one screen, show locations of each on sketch.