

PRENTISS
E 50
6-1-71

MISSISSIPPI
BOARD OF WATER COMMISSIONERS
416 North State Street
Jackson, Mississippi 39201

WATER WELL DRILLERS LOG

CODED

6-1 1971 Bonds Well Drilling Prentiss
date well completed firm name county well located

LANDOWNER: Charles Young
Boonville Miss
(mailing address)

description of formations encountered	from	to
Red clay	0	15
Red sand	15	33
Blue clay	33	110
Water sand	110	150

WELL LOCATION:
sec. 34 T 5 N R 6 E
5 miles West of Boonville
(distance) (direction) (nearest town)

WELL PURPOSE: Home
(home, irrigation, municipal, industrial)

- WELL COMPLETION DATA:
- (1) diameter (inches) 4
 - (2) total depth (feet) 150
 - (3) static water level (feet) 18 below above top of ground.
 - (4) casing Steel 142
(material) (depth)
(size) if telescope see back.
 - (5) screen None
(length) (depth to top)
(size) (material)
 - (6) pump 1/2 5
(HP) (yield gpm)
Electric
(type power)
 - (7) electric log no
(yes or no)
(organization running log)
 - (8) how well bottom plugged Open

CODED


APR 14 1971

DRILLERS REMARKS:

MISS. BD. OF
WATER COM.

If well telescopes please sketch and show depths.

GROUND LEVEL

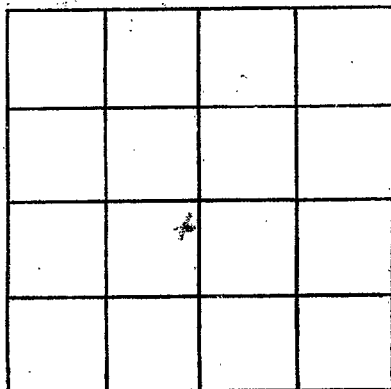

SECTION _____

Please indicate well location X.

ADDITIONAL INFORMATION

If more than one screen,
show locations of each on sketch.