

PRENTISS

E 53

11-25-71

MISSISSIPPI BOARD OF WATER COMMISSIONERS
416 North State Street
Jackson, Mississippi 39201

DEC 9 1971

WATER WELL DRILLERS LOG

MISS. DIV. OF
WATER
RESOURCES
COMM.

11-25
date well completed

1971 Bonds Well Drilling
firm name

county well located

LANDOWNER: Jerry Childers

description of formations encountered

from to

Brownsville Miss
(mailing address)

Red Clay	0	22
Red sand	22	76
Blue Clay	76	2216
Water sand	160	190

WELL LOCATION:

sec. 14 T. 5 N. R. 6 E.
S. W.

4 miles West of Brownsville
(distance) (direction) (nearest town)

WELL PURPOSE: Home
(home, irrigation, municipal, industrial)

WELL COMPLETION DATA:

- (1) diameter (inches) 4
- (2) total depth (feet) 190
- (3) static water level (feet) 29 below above top of ground.

(4) casing Steel, 24
(material) (depth)
(size) if telescope see back.

(5) screen None
(length) (depth to top)
(size) (material)

(6) pump 3/4 5
(HP) (yield gpm)

Electric
(type power)

(7) electric log (yes or no)

(organization running log)


(8) how well bottom plugged Open

DRILLERS REMARKS:

CODED

If well telescopes please sketch and show depths.

GROUND LEVEL

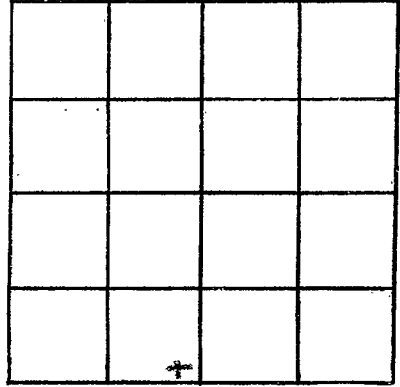

SECTION _____

Please indicate well location X.

ADDITIONAL INFORMATION

A series of horizontal lines for writing additional information.

If more than one screen, show locations of each on sketch.