

Prentiss

E 57

11-2-73

MISSISSIPPI  
 BOARD OF WATER COMMISSIONERS  
 416 North State Street  
 Jackson, Mississippi 39201

WATER WELL DRILLERS LOG

CODED

11-2  
date well completed

1973 Bonds Well Drilling  
firm name

Prentiss  
county well located

LANDOWNER: James H. Spencer

Boneville, Miss

(mailing address)

description of formations encountered

from

to

Red clay  
Blue clay  
Water sand

0 36  
36 97  
97 150

WELL LOCATION:

sec 25 T 5 N R 6 E  
5 miles W of Boneville  
(distance) (direction) (nearest town)

WELL PURPOSE: Home  
(home, irrigation, municipal, industrial)

WELL COMPLETION DATA:

- (1) diameter (inches) 4"
- (2) total depth (feet) 150'
- (3) static water level (feet) 36 below top of ground.
- (4) casing Steel, 42' (material) (depth)

CODED

(size) If telescope see back.

- (5) screen None (length) (depth to top)

(size) (material)  
(6) pump 3/4 5 (HP) (yield gpm)

Elec. (type power)

- (7) electric log NO (yes or no)


(organization running log)

- (8) how well bottom plugged open

DRILLERS REMARKS:

If well telescopes please sketch and show depths.

GROUND LEVEL

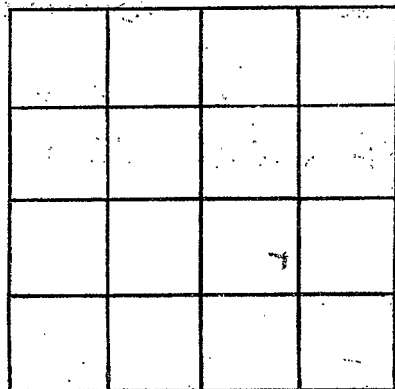

SECTION \_\_\_\_\_

Please indicate well location X.

ADDITIONAL INFORMATION

If more than one screen,  
show locations of each on sketch.