

Prentiss  
 ESI  
 3-29-74

MISSISSIPPI  
 BOARD OF WATER COMMISSIONERS  
 416 North State Street  
 Jackson, Mississippi 39201


CODED

WATER WELL DRILLERS LOG

3-29-1974 date well completed      Bonds Well Drilling firm name      Prentiss county well located

LANDOWNER: <u>Donald Young</u> <u>Rt 3</u>	description of formations encountered	from	to
<u>Boneville, Miss.</u> (mailing address)			
WELL LOCATION: sec. <u>12</u> T <u>5</u> N R <u>6</u> E <u>3</u> miles <u>West</u> of <u>Boneville</u> (distance) (direction) (nearest town)	<u>Blue clay</u>	<u>30</u>	<u>60</u>
WELL PURPOSE: <u>home</u> (home, irrigation, municipal, industrial)	<u>Red sand</u>	<u>60</u>	<u>95</u>
WELL COMPLETION DATA: (1) diameter (inches) <u>4"</u>	<u>Blue clay</u>	<u>95</u>	<u>170</u>
(2) total depth (feet) <u>215</u>	<u>Water sand</u>	<u>170</u>	<u>215</u>
(3) static water level (feet) <u>60</u> <u>below</u> above top of ground.			
(4) casing <u>Steel</u> , <u>105</u> , (material) (depth)			
(5) screen <u>None</u> (length) (depth to top)			
(6) pump <u>hand pump</u> (HP) (yield-gpm)			
(7) electric log <u>no</u> (yes or no)			
(8) how well bottom plugged <u>open</u>			
DRILLERS REMARKS:			


CODED

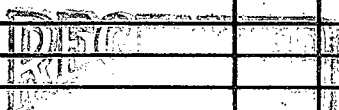

JUN 26 1974

If well telescopes please sketch and show depths.

GROUND LEVEL

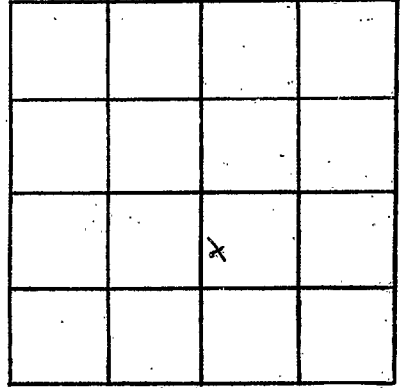

SECTION \_\_\_\_\_

Please indicate well location X.

ADDITIONAL INFORMATION

If more than one screen, show locations of each on sketch.