

Prentiss
 ESJ
 2-22-74

MISSISSIPPI
 BOARD OF WATER COMMISSIONERS
 416 North State Street
 Jackson, Mississippi 39201

CODED

WATER WELL DRILLERS LOG

2-22 1974 Bonds Well Drilling Prentiss
 date well completed firm name county well located

LANDOWNER: W.D. White
 R.t. 3

description of formations encountered	from	to
Red Mounds	0	17
Blue clay	17	175
Water sand	175	215

Booneville, Ms.
 (mailing address)

WELL LOCATION:
 sec. 1 T. 5 N R. 6 E
 2 1/2 miles West of Booneville
 (distance) (direction) (nearest town)

CODED

WELL PURPOSE: home
 (home, irrigation, municipal, industrial)

- WELL COMPLETION DATA:
- (1) diameter (inches) 4"
 - (2) total depth (feet) 215
 - (3) static water level (feet) 80 ^{below} _{above} top of ground.
 - (4) casing Steel, 21
 (material) (depth)
 (size) if telescope see back.
 - (5) screen None
 (length) (depth to top)
 (size) (material)
 - (6) pump 3/4 10
 (HP) (yield gpm)
 Submersible
 (type power)
 - (7) electric log No
 (yes or no)
 (organization running log)
 - (8) how well bottom plugged open


RECORDED
 INDEXED
 JUN 26 1974

DRILLERS REMARKS:

MISS. BD. OF WATER COMMISSIONERS

If well telescopes please sketch and show depths.

GROUND LEVEL

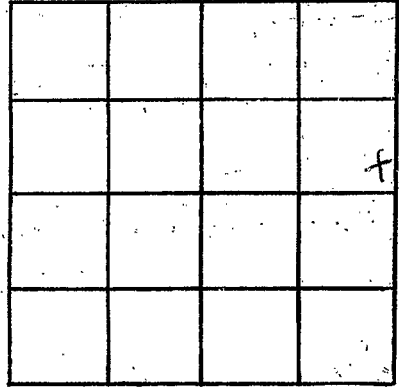

SECTION _____

Please indicate well location X.

ADDITIONAL INFORMATION

If more than one screen, show locations of each on sketch.