

PRENTISS  
E 60  
1-8-75

MISSISSIPPI  
BOARD OF WATER COMMISSIONERS  
416 North State Street  
Jackson, Mississippi 39201

CODED.

WATER WELL DRILLERS LOG

1-8 1975 Bonds Well Drilling Prentiss  
date well completed firm name county well located


LANDOWNER: <u>Virginia Barber</u> <u>Booneville</u> <u>Miss</u> (mailing address)	description of formations encountered	from	to
	<u>Red Dumbo</u>	<u>0</u>	<u>27</u>
	<u>Blue Clay</u>	<u>27</u>	<u>213</u>
	<u>Water Sand</u>	<u>213</u>	<u>258</u>
WELL LOCATION: sec. <u>28</u> T. <u>50</u> N. R. <u>6</u> E. <sup>13b</sup> <u>5</u> miles <u>W</u> of <u>Booneville</u> (distance) (direction) (nearest town)			
WELL PURPOSE: <u>Home</u> (home, irrigation, municipal, industrial)			
WELL COMPLETION DATA:			
(1) diameter (inches) <u>4"</u>			
(2) total depth (feet) <u>258</u>			
(3) static water level (feet) <u>80</u> <sup>(below)</sup> <sub>above</sub> top of ground.			
(4) casing <u>Steel</u> , <u>34</u> , (material) (depth) (size) if telescope see back.			
(5) screen <u>None</u> (length) (depth to top) (size) (material)			
(6) pump <u>3/4</u> <u>10</u> (HP) (yield gpm) <u>Sub</u> (type power)			
(7) electric log <u>NO</u> (yes or no) (organization running log)			
(8) how well bottom plugged <u>open</u>			
DRILLERS REMARKS:			

CODED.

RECEIVED  
MAR 13 1975

If well telescopes please  
sketch and show depths.

GROUND LEVEL

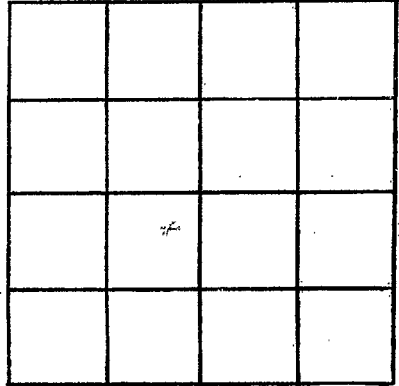

SECTION \_\_\_\_\_

Please indicate well location X.

ADDITIONAL INFORMATION

If more than one screen,  
show locations of each on sketch.