

E 2000

3-4-62

WATER WELL DRILLERS LOG

HERNDON WELL & SUPPLY CO.

Date: 3-4, 1962, Driller: SHANNON P. O. BOX 42 County Prentiss
(Name) MISSISSIPPI

(1) Owner of Land: <u>Bud Eaton</u> <small>(Name)</small>	Description & Color of Materials Sand, Clay, Red Clay, Shell, etc.	Thick- ness Feet	Depth Feet
<u>Boonville, Miss.</u> <small>(Address)</small>	<u>SAND & clay</u>		<u>0</u>
(2) Location: <u>1/4</u> , <u>1/4</u> , Sec. <u>4</u> , T. <u>33 N</u> , R. <u>6 E</u> <u>10 miles</u> <u>West</u> , of <u>Boonville</u> <small>(distance)</small> <small>(direction)</small> <small>(Nearest Town)</small>	<u>Blue Rock</u>		<u>20</u>
(3) Topography: <u>Hilly</u> <small>(Hilly)</small> <small>(Flat)</small> <small>(Level)</small>	<u>Hard Rock</u>		<u>80</u>
(4) Purpose of Well: <u>Domestic</u> <small>(Domestic Irrigation Municipal, Industrial, Other)</small>	<u>SAND</u>		<u>82</u>
	<u>Bottom</u>		<u>240</u>
			<u>360</u>


Information upon completion of well:

- (1) Diameter 4 inches.
- (2) Total Depth 360 feet.
- (3) Water Level 123' feet below top of ground.
- (4) Cased to 36 ft, Size 4"
- (5) Screen: Size , Length
- (6) Were any formations sealed against pollution?

yes, no.

If YES depth of formation 30 ft
 Why Smother & Sand

Drillers Remarks:

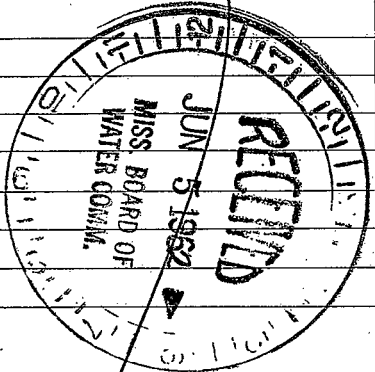

(Use Back Side)

Well No.

