

WATER WELL DRILLERS LOG

Prentiss  
E 2001  
11-66

Date: Nov 3, 1966, Driller: Bonds of Dumbing County Prentiss  
(Name)

(1) Owner of Land: <u>Bill Coats</u> (Name)	Description & Color of Materials Sand, Clay, Red Clay, Shell, etc.	Thick- ness Feet	Depth Feet
<u>Rt 2 Baldwyn Miss</u> (Address)	<u>red sand</u>	<u>38</u>	<u>38</u>
(2) Location: <u>N 1/4, 1/4, Sec 79 T5 R6E</u>	<u>Blue Clay</u>	<u>200</u>	<u>238</u>
<u>7</u> miles <u>North-West</u> of <u>Baldwyn</u> (distance) (direction) (Nearest Town)	<u>water sand</u>	<u>62</u>	<u>300</u>
(3) Topography: <u>Level</u> (Hilly) (Flat) (Level)			
(4) Purpose of Well: <u>Home</u> (Domestic Irrigation Municipal, Industrial, Other)			


Information upon completion of well:

- (1) Diameter 4 inches.
- (2) Total Depth 300 feet.
- (3) Water Level 2 feet below top of ground.
- (4) Cased to 42, Size 4"
- (5) Screen: Size none, Length \_\_\_\_\_
- (6) Were any formations sealed against pollution?  
\_\_\_\_\_ yes, no no.

If YES depth of formation \_\_\_\_\_

Why \_\_\_\_\_

Drillers Remarks: \_\_\_\_\_

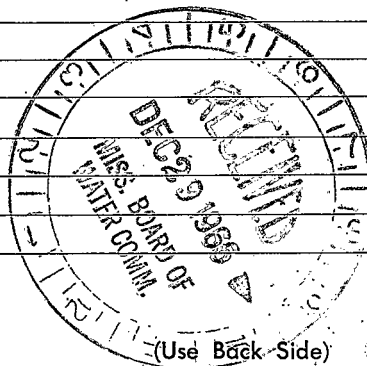

Well No. \_\_\_\_\_

