

MISSISSIPPI
BOARD OF WATER COMMISSIONERS
416 North State Street
Jackson, Mississippi 39201

WATER WELL DRILLERS LOG

Prentiss
E 2004
3-67

Mar 14, 1967 19 *Bards Plumbing & Drilling Co* *Prentiss*
date well completed firm name county well located

LANDOWNER: *Kermit Jones*
Route 2
Booneville, Miss
(mailing address)


description of fomations encountered	from	to
<i>White Lumps</i>	<i>8</i>	<i>19</i>
<i>Hard Blue Clay</i>	<i>19</i>	<i>95</i>
<i>Soft " + Shales</i>	<i>95</i>	<i>128</i>
<i>Water Sand</i>	<i>128</i>	<i>160</i>

WELL LOCATION:
sec. *12* T. *25* N. R. *4* E
S *W*
5 miles *West* of *Booneville*
(distance) (direction) (nearest town)

WELL PURPOSE: *Home*
(home, irrigation, municipal, industrial)

- WELL COMPLETION DATA:
- diameter (inches) *4"*
 - total depth (feet) *160*
 - static water level (feet) *65* below above top of ground.
 - casing *lb. steel*, *21"* (material), (depth)
4" (size) if telescope see back.
 - screen *none* (length), (depth to top)
(size), (material)
 - pump _____ (HP) _____ (yield gpm)
(type power) *install*
 - electric log *no* (yes or no)
did (organization running log)
 - how well bottom plugged *open*

DRILLERS REMARKS:

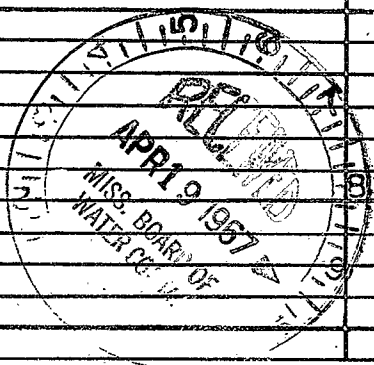

If well telescopes please sketch and show depths.

GROUND LEVEL

X			

SECTION 12

Please indicate well location X.

ADDITIONAL INFORMATION

If more than one screen,
show locations of each on sketch.