

Prentiss
E 2005
6-67

MISSISSIPPI
BOARD OF WATER COMMISSIONERS
416 North State Street
Jackson, Mississippi 39201

WATER WELL DRILLERS LOG

June 14 1967 date well completed
Lands Plumbing firm name
Prentiss county well located

LANDOWNER: Guy Jones
Contractor
Booneville Miss
(mailing address)

description of formations encountered	from	to
Yellow clay	0'	21'
Blue "	21'	113'
Water Sand	113'	174'

WELL LOCATION:
sec. 27 S N R 6 E
6 miles W of Booneville
(distance) (direction) (nearest town)

WELL PURPOSE: Home
(home, irrigation, municipal, industrial)


- WELL COMPLETION DATA:
- (1) diameter (inches) 4"
 - (2) total depth (feet) 174'
 - (3) static water level (feet) Not known below top of ground.
 - (4) casing Steel, 22' (material) (depth)
4" (size) if telescope see back.
 - (5) screen none (length) (depth to top)
none (size) (material)
 - (6) pump none (HP) (yield gpm)
(type power)
 - (7) electric log no (yes or no)
none (organization running log)
 - (8) how well bottom plugged open



DRILLERS REMARKS:

If well telescopes please sketch and show depths.

GROUND LEVEL

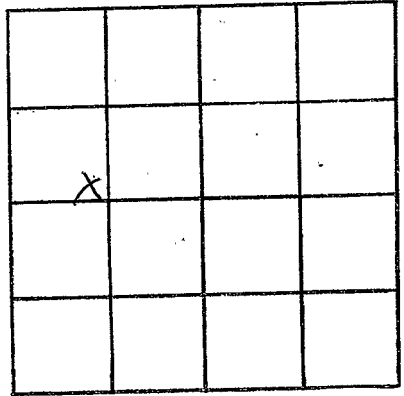

SECTION 2

Please indicate well location X.

ADDITIONAL INFORMATION

If more than one screen, show locations of each on sketch.