

Orestis
E 2000
9-67

MISSISSIPPI
BOARD OF WATER COMMISSIONERS
416 North State Street
Jackson, Mississippi 39201

WATER WELL DRILLERS LOG

Sept 13 1967 date well completed
Bond Plumbing & Drilling firm name
Orestis county well located

LANDOWNER: Cecil Kean Jr.
#2 Baldwin
Miss
(mailing address)

description of formations encountered	from	to
Yellow & Blue Clay	0'	20'
Blue Clay	20'	230'
Water Sand	230'	300'

WELL LOCATION:
sec. 28 5 N R 6 E
S W
8 miles WSW of Rossville
(distance) (direction) (nearest town)

WELL PURPOSE: Home
(home, irrigation, municipal, industrial)


- WELL COMPLETION DATA:
- (1) diameter (inches) 4"
 - (2) total depth (feet) 300'
 - (3) static water level ~~not known~~ below top of ground.
 - (4) casing ~~21~~ 21 (material) (depth)
12" (size) if telescope see back.
 - (5) screen none
(length) (depth to top)
(size) (material)
 - (6) pump ~~not known~~ 1/2 HP yield gpm
(type power) Pump Set Run
 - (7) electric log (yes or no)
 - (organization running log)
 - (8) how well bottom plugged open

DRILLERS REMARKS:



If well telescopes please sketch and show depths.

GROUND LEVEL

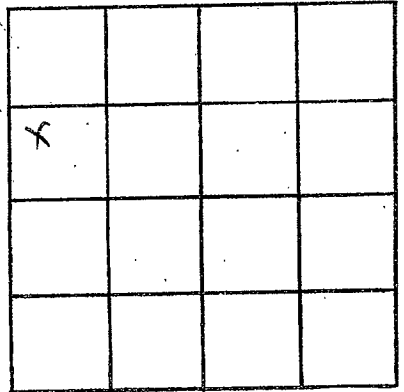

SECTION 28

Please indicate well location X.

ADDITIONAL INFORMATION

Lined area for additional information.

If more than one screen, show locations of each on sketch.