

Prentiss
E2007
8-8-68

MISSISSIPPI
BOARD OF WATER COMMISSIONERS
416 North State Street
Jackson, Mississippi 39201

WATER WELL DRILLERS LOG

Aug 8 1968 Bonds Prentiss
date well completed firm name county well located

LANDOWNER: James Davis

description of formations encountered

from to

(mailing address)

WELL LOCATION:

sec. 28 T 5 N R 6 E
6 miles SW of Booneville
(distance) (direction) (nearest town)

WELL PURPOSE: Home
(home, irrigation, municipal, industrial)

WELL COMPLETION DATA:


- (1) diameter (inches) 4
- (2) total depth (feet) 240
- (3) static water level (feet) 65 below above top of ground.
- (4) casing Steel 21
4 in (material) (depth)
If telescope see back.
(size)
- (5) screen None
(length) (depth, to top)
None
(size) (material)
- (6) pump Installed Sun Pump
(HP) (field gpm)

(type power)

- (7) electric log no
(yes or no)
None
(organization running log)


- (8) how well bottom plugged Open

DRILLERS REMARKS:

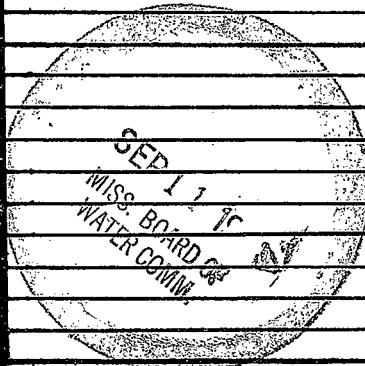

If well telescopes please sketch and show depths.

GROUND LEVEL

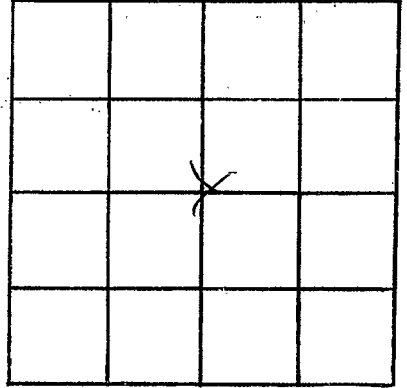

SECTION 28

Please indicate well location X.

ADDITIONAL INFORMATION

If more than one screen,
show locations of each on sketch.