

Prentiss
E 2008
8-12-68

MISSISSIPPI
 BOARD OF WATER COMMISSIONERS
 416 North State Street
 Jackson, Mississippi 39201

WATER WELL DRILLERS LOG

Aug 13 1968 Bonds Prentiss
 date well completed firm name county well located

LANDOWNER: Frank Davis

description of formations encountered	from	to


(mailing address)

WELL LOCATION:
 sec. 28 T. 5 N R. 6 E
6 miles SW of Boonville
 (distance) (direction) (nearest town)

<u>Grey Clay</u>	<u>0</u>	<u>15</u>
<u>Sandy loam</u>	<u>15</u>	<u>20</u>
<u>Blue loam</u>	<u>20</u>	<u>175</u>
<u>Water sand</u>	<u>175</u>	<u>240</u>

WELL PURPOSE: Home
 (home, irrigation, municipal, industrial)


- WELL COMPLETION DATA:
- (1) diameter (inches) 4"
 - (2) total depth (feet) 240
 - (3) static water level (feet) 105 below above top of ground.
 - (4) casing Steel, 42,
4" (material) (depth)
4" if telescope see back.
 (size)
 - (5) screen None
 (length) (depth to top)
None (size) (material)
 - (6) Installed down pump
Electric
 (type power)
None (HP) (yield gpm)
 - (7) electric log No
 (yes or no)
None (organization running log)
 - (8) how well bottom plugged Open

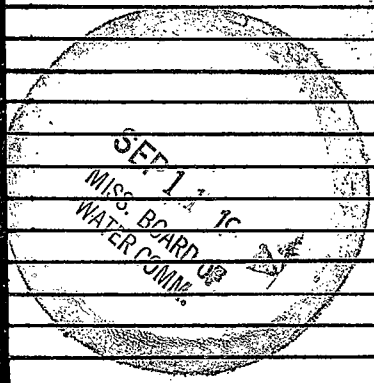

DRILLERS REMARKS:

If well telescopes please sketch and show depths.

GROUND LEVEL

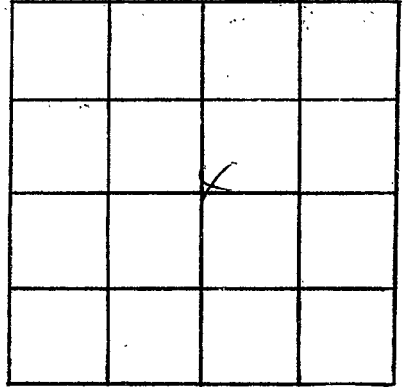

SECTION 28

Please indicate well location X.

ADDITIONAL INFORMATION

If more than one screen,
show locations of each on sketch.