

PRENTISS
E 2009
11/75

MISSISSIPPI
BOARD OF WATER COMMISSIONERS
416 North State Street
Jackson, Mississippi 39201

WATER WELL DRILLERS LOG

Nov 1975 - J.W. Webberson Prentiss
date well completed firm name county well located

LANDOWNER: Ronie Roland
Booneville, Miss
(mailing address)

description of formations encountered	from	to
soil	0	1
Bumbo & sand	1	85
Blue Rock	85	115
water sand	185	200

WELL LOCATION:
sec. 14 T53 N R. 6 E
1 1/2 miles East of Booneville
(distance) (direction) (nearest town)

WELL PURPOSE:
(home, irrigation, municipal, industrial)

- WELL COMPLETION DATA:
- (1) diameter (inches) 4
 - (2) total depth (feet) 200
 - (3) static water level (feet) 90 below above top of ground.
 - (4) casing Steel, 105 ft
(material) (depth)
4" if telescope see back.
(size)
 - (5) screen 0 0
(length) (depth to top)
(size) (material)
 - (6) pump 0 0
(HP) (yield gpm)
(type power)
 - (7) electric log (yes or no)
 - (organization running log)
 - (8) how well bottom plugged

DRILLERS REMARKS:




NOV 21 1975

MISSISSIPPI BOARD OF WATER COMMISSIONERS

If well telescopes please sketch and show depths.

GROUND LEVEL

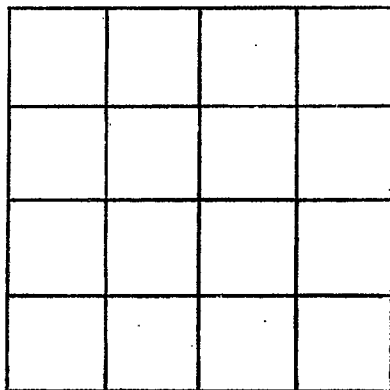

SECTION _____

Please indicate well location X.

ADDITIONAL INFORMATION

If more than one screen,
show locations of each on sketch.