

PRENTISS
E 2010

MISSISSIPPI
BOARD OF WATER COMMISSIONERS
416 North State Street
Jackson, Mississippi 39201

RECEIVED

WATER WELL DRILLERS LOG


MAY 23 1986

8-13 1985 Bands Well Drilling Ant of Prentiss
date well completed firm name Bureau of Land & Well Records

LANDOWNER: <u>Roger Spencer</u>	description of formations encountered	from	to
<u>Booneville, ms. 38829</u> (mailing address)	<u>Red clay</u> <u>Blue clay</u> <u>Water sand</u>	<u>0</u> <u>36</u> <u>105</u>	<u>36</u> <u>105</u> <u>150</u>
WELL LOCATION:			
sec. <u>24</u> T <u>5</u> N R <u>6</u> E <u>3</u> miles <u>West</u> of <u>Booneville</u> (distance) (direction) (nearest town)			
WELL PURPOSE: <u>home</u> (home, irrigation, municipal, industrial)			
WELL COMPLETION DATA:			
(1) diameter (inches) <u>4"</u>			
(2) total depth (feet) <u>150'</u>			
(3) static water level (feet) <u>30'</u> below above top of ground.			
(4) casing <u>Plastic, 40'</u> (material) (depth)			
_____ if telescope see back. (size)			
(5) screen <u>none</u> (length) (depth to top)			
_____ (size) _____ (material)			
(6) pump <u>Jet</u> <u>5</u> (HP) (yield gpm)			
_____ (type power)			
(7) electric log <u>no</u> (yes or no)			
_____ (organization running log)			
(8) how well bottom plugged <u>open</u>			
DRILLERS REMARKS:			

If well telescopes please sketch and show depths.

GROUND LEVEL

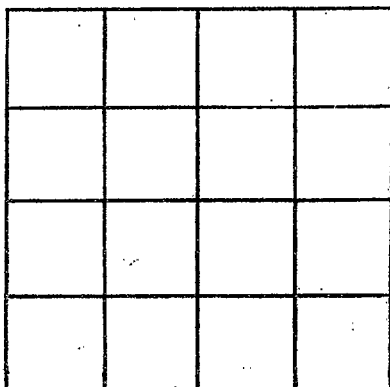

SECTION _____

Please indicate well location X.

ADDITIONAL INFORMATION

If more than one screen, show locations of each on sketch.