

PRENTISS MISSISSIPPI BOARD OF WATER COMMISSIONERS

F

3-8-62

WATER WELL DRILLERS LOG

Date March 8, 1962, Driller: HERNDON WELL & SUPPLY CO. County Prentiss

P.O. BOX 42  
SHANNON, MISSISSIPPI

(1) Owner of Land:	Description & Color of Materials Sand, Clay, Red Clay, Shell, etc.	Thick- ness Feet	Depth Feet
<u>Island Game</u> (Name) <u>Bearville, Miss</u> (Address)	<u>Surface sand</u> <u>&amp; clay</u>		<u>0</u>
(2) Location: <u>1/4</u> , <u>1/4</u> , Sec. <u>    </u> T. <u>    </u> R. <u>    </u>	<u>Blue water</u>		<u>20</u>
<u>4</u> miles <u>West</u> of <u>Bearville</u> (distance) (direction) (Nearest Town)	<u>Sand</u>		<u>100</u>
(3) Topography: <u>Hilly</u> (Hilly) (Flat) (Level)	<u>Bottom</u>		<u>220</u>
(4) Purpose of Well: <u>Domestic</u> (Domestic Irrigation Municipal, Industrial, Other)			


Information upon completion of well:

- (1) Diameter 4 inches.
- (2) Total Depth 220 feet.
- (3) Water Level      feet below top of ground.
- (4) Cased to 23 ft. Size 4"
- (5) Screen: Size     , Length
- (6) Were any formations sealed against pollution?  
   yes,      no.

If YES depth of formation 20 ft.

Why surface sand

Drillers Remarks:     

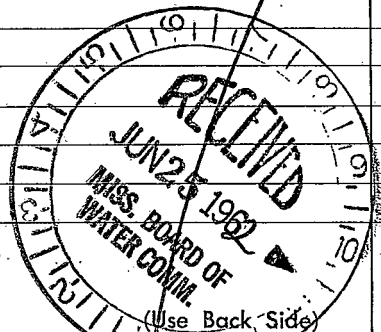

Well No.