

Prentiss
F

5-31-66 MISSISSIPPI BOARD OF WATER COMMISSIONERS

WATER WELL DRILLERS LOG

Date: May 31, 1966, Driller: Bonds Ply. Drng. County: Prentiss
(When well drilled) (Name) (Where well is located)

(1) Owner of Land: <u>Red Vandeweyer</u> (Name)	Description & Color of Materials Sand, Clay, Red Clay, Shell, etc.	Thick- ness Feet	Depth Feet
<u>Boonville Miss</u> (Address)			
(2) Location: <u>West</u> 1/4, Sec. _____ T. _____ R. _____			
_____ miles _____ of _____ (distance) (direction) (Nearest Town)			
(3) Topography: _____ (Hilly) (Flat) (Level)	<u>Thin blue</u>	<u>42</u>	<u>5</u>
(4) Purpose of Well: <input checked="" type="radio"/> (Domestic) <input type="radio"/> Irrigation <input type="radio"/> Municipal, <input type="radio"/> Industrial, <input type="radio"/> Other	<u>Coarse Sand</u>	<u>90</u>	

Information upon completion of well:

(1) Diameter 4 inches.

(2) Total Depth 115 feet. Gravel

(3) Water Level _____ feet below top of ground.

(4) Cased to bottom Size 4"

(5) Screen: Size _____, Length _____.

(6) Were any formations sealed against pollution?
_____ yes, _____ no.

If YES depth of formation _____


Why _____

Drillers Remarks: _____

Yield in gpm: _____

Size pump: _____

Type power: Elect

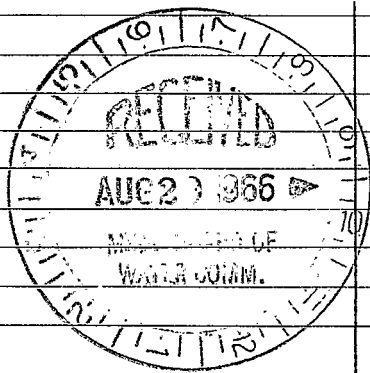

Retain this copy for your office files.