

WATER WELL DRILLERS LOG

Herndon Well & Supply Co.

3-9-61

Date: 3/9, 1961, Driller: SHANNON, MISS. County Prentiss

(Name)

(1) Owner of Land: Bill Cox
(Name)
Rt 2 Bousville, Miss.
(Address)

(2) Location: 1/4, 1/4, Sec. T R
4 miles South of Bousville
(distance) (direction) (Nearest Town)

(3) Topography: Flat
(Hilly) (Flat) (Level)

(4) Purpose of Well: Home Use
(Domestic Irrigation
Municipal, Industrial, Other)


Description & Color of Materials Sand, Clay, Red Clay, Shell, etc.	Thick- ness Feet	Depth Feet
Sand & Clay Blue rock		25
Sand ↓		70
Bottom		180

Information upon completion of well:

- (1) Diameter 4 inches.
- (2) Total Depth 180 feet.
- (3) Water Level 30 feet below top of ground.
- (4) Cased to 30' 10", Size 4"
- (5) Screen: Size —, Length —
- (6) Were any formations sealed against pollution?
 yes, no.

If YES depth of formation 25 ft
Why Swales & Sand

Drillers Remarks:

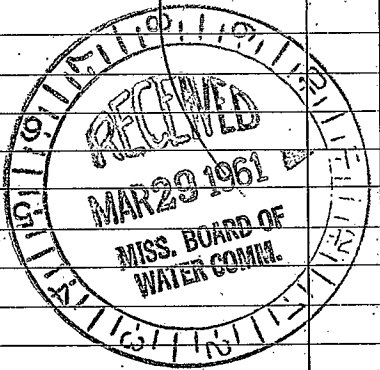

(Use Back Side)

Well No.