

PRENTISS WATER WELL DRILLERS LOG

Date: Mar 16, 1963, Driller: Bands County Prentiss
 3-16-62 (Name)


(1) Owner of Land:	Description & Color of Materials Sand, Clay, Red Clay, Shell, etc.	Thick- ness Feet	Depth Feet
<u>Jack Dubard</u> (Name) <u>Booneville Miss</u> (Address)	<u>Bumbo</u> <u>red sand</u>	<u>20</u>	<u>20</u>
(2) Location: <u>1/4</u> , <u>1/4</u> , Sec. <u> </u> T. <u> </u> R. <u> </u> <u>4</u> miles <u>west</u> of <u>Booneville</u> (distance) (direction) (Nearest Town)	<u>6 ft blue</u> <u>46 ft white</u> <u>sand</u>		
(3) Topography: <u>flat</u> (Hilly) (Flat) (Level)	<u>100 ft hit road</u> <u>5 ft 6"</u>		
(4) Purpose of Well: <u>Domestic</u> (Domestic Irrigation Municipal, Industrial, Other)	<u>115 ft road 24"</u> <u>125 water sand</u>		

Information upon completion of well:

- (1) Diameter 4 inches.
- (2) Total Depth 172 feet.
- (3) Water Level 45' feet below top of ground.
- (4) Cased to 42 1/8", Size 4"
- (5) Screen: Size , Length
- (6) Were any formations sealed against pollution?
 yes, no.

If YES depth of formation 42 1/8 ft
 Why

Drillers Remarks:

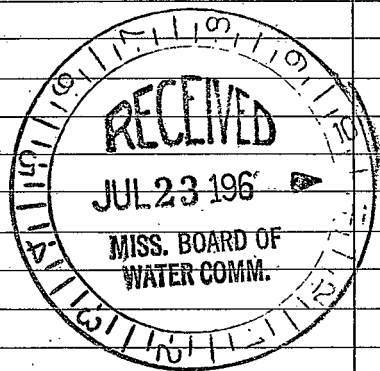

(Use Back Side)

Well No.