

**PRENTISS**  
**F10**  
**10-12-72**

**MISSISSIPPI**  
**BOARD OF WATER COMMISSIONERS**  
 416 North State Street  
 Jackson, Mississippi 39201

**WATER WELL DRILLERS LOG**

10-12 1972 Boonville **CODED** Prentiss  
 date well completed year town name county well located

LANDOWNER: Edward Hamble  
Boonville Miss.  
 (mailing address)

description of formations encountered	from	to
<u>Red clay</u>	<u>0</u>	<u>22</u>
<u>blue sand</u>	<u>22</u>	<u>60</u>
<u>blue clay</u>	<u>60</u>	<u>246</u>
<u>water level</u>	<u>246</u>	<u>300</u>

WELL LOCATION:  
 sec. 35 T 5 N R 7 E  
5 miles S-E of Boonville  
 (distance) (direction) (nearest town)

WELL PURPOSE: Home  
 (home, irrigation, municipal, industrial)

- WELL COMPLETION DATA:
- (1) diameter (inches) 4
  - (2) total depth (feet) 300
  - (3) static water level (feet) 110 below above top of ground.
  - (4) casing Steel 81  
 (material) (depth)  
 \_\_\_\_\_ if telescope see back.  
 (size)
  - (5) screen none  
 (length) (depth to top)  
 \_\_\_\_\_  
 (size) (material)
  - (6) pump Hand 100  
 (type power) (yield gpm)
  - (7) electric log no  
 (yes or no)  
 \_\_\_\_\_  
 (organization running log)
  - (8) how well bottom plugged open


**CODED**

DRILLERS REMARKS:

DEC 14 1972

If well telescopes please  
sketch and show depths.

GROUND LEVEL

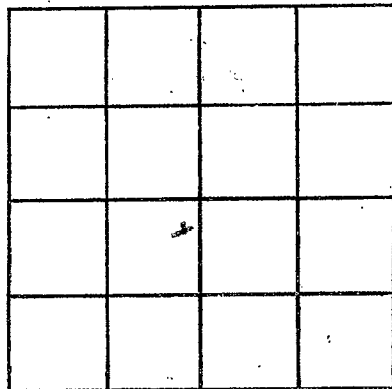

SECTION \_\_\_\_\_

Please indicate well location X.

ADDITIONAL INFORMATION

If more than one screen,  
show locations of each on sketch.