

PRENTISS
F-45
8-5-71

MISSISSIPPI
BOARD OF WATER COMMISSIONERS
416 North State Street
Jackson, Mississippi 39201

WATER WELL DRILLERS LOG

CODED

8-5 date well completed 1971 Bonds Well Drilling firm name Prentiss county well located

LANDOWNER: Herbert Arnold
Bonville Miss
(mailing address)

description of formations encountered	from	to
Red Clay	0	36
Blue Clay	36	140
Water Sand	140	180

WELL LOCATION:
sec. 28 T. 5 N R. 7 E
4 miles S-E of Bonville
(distance) (direction) (nearest town)

WELL PURPOSE: Home
(home, irrigation, municipal, industrial)

- WELL COMPLETION DATA:
- (1) diameter (inches) 4
 - (2) total depth (feet) 180
 - (3) static water level (feet) 60 below above top of ground.
 - (4) casing Steel, 42
(material) (depth)
(size) if telescope see back.
 - (5) screen none
(length) (depth to top).
(size) (material)
 - (6) pump Had on pump
(HP) (yield gpm)
(type power)
 - (7) electric log No
(yes or no)
(organization running log)
 - (8) how well bottom plugged open

CODED


SEP 20 1971

DRILLERS REMARKS:

MISS. BD. OF
WATER COMMISSIONERS

If well telescopes please sketch and show depths.

GROUND LEVEL

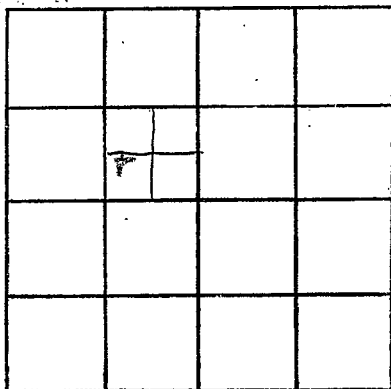

SECTION _____

Please indicate well location X.

ADDITIONAL INFORMATION

If more than one screen, show locations of each on sketch.