

PRENTISS
F 46
6-22-73

MISSISSIPPI
 BOARD OF WATER COMMISSIONERS
 416 North State Street
 Jackson, Mississippi 39201

CODED

WATER WELL DRILLERS LOG

6-22 1973 Bonds Well Drilling Prentiss
 date well completed firm name county well located

LANDOWNER: William Young
Bronoville, Miss.

description of formations encountered

from to

	0	
Red clay	0	18
Sandy Blue	18	98
Blue clay	98	190
water sand	190	240

(mailing address)

WELL LOCATION:

sec. 7 T. 5 N. R. 7 E
3 miles W of Bronoville
 (distance) (direction) (nearest town)

WELL PURPOSE: Home
 (home, irrigation, municipal, industrial)

WELL COMPLETION DATA:

(1) diameter (inches) 4
 (2) total depth (feet) 240
 (3) static water level (feet) 80 below above top of ground.
 (4) casing Steel, 105,
 (material) (depth)

CODED

 if telescope see back.
 (size)
 (5) screen None
 (length) (depth to top)

 (size) (material)
 (6) pump head on pump
 (HP) (yield gpm)

 (type power)
 (7) electric log NO
 (yes or no)


 (organization running log)
 (8) how well bottom plugged open

DRILLERS REMARKS:

JUL 5 1973

If well telescopes please sketch and show depths.

GROUND LEVEL

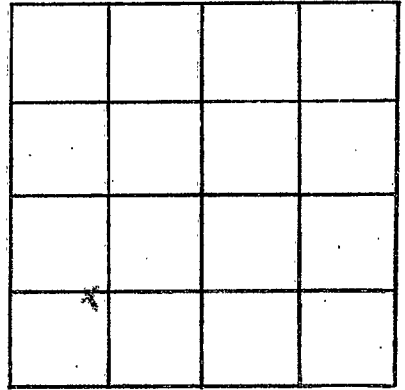

SECTION _____

Please indicate well location X.

ADDITIONAL INFORMATION

If more than one screen, show locations of each on sketch.