

13B

Prentiss  
750  
10-24-68

MISSISSIPPI  
BOARD OF WATER COMMISSIONERS  
416 North State Street  
Jackson, Mississippi 39201

CODED

WATER WELL DRILLERS LOG

Oct 24 1968 Bonds Prentiss  
date well completed firm name county well located

LANDOWNER: Dr. Mary Clark  
Rt 4 Boonewille  
Miss  
(mailing address)

description of formations encountered	from	to
<u>red clay &amp; sand</u>	<u>0</u>	<u>35</u>
<u>sandy blue</u>	<u>35</u>	<u>120</u>
<u>water sand streaks</u>	<u>120</u>	<u>200</u>


WELL LOCATION:  
sec 22 T 5 N R 7 E  
1 miles South of Boonewille  
(distance) (direction) (nearest town)

WELL PURPOSE: Home  
(Home, irrigation, municipal, industrial)

WELL COMPLETION DATA:  
(1) diameter (inches) 4  
(2) total depth (feet) 200  
(3) static water level not known below top of ground.  
(4) casing steel, 42,  
(material) (depth)  
4"  
(size) If telescope see back.  
(5) screen not  
(length) (depth to top)  
(6) pump didn't install pump (HP) (material) (yield gpm)

(type power)  
(7) electric log no (yes or no)  
(organization running log)  
(8) how well bottom plugged Open


DRILLERS REMARKS:

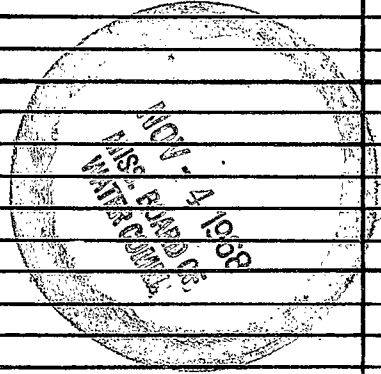

CODED

If well telescopes please sketch and show depths.

GROUND LEVEL

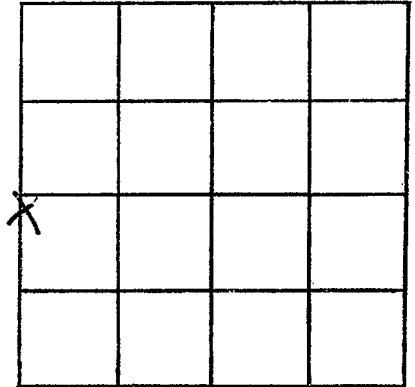

SECTION 22

Please indicate well location X.

ADDITIONAL INFORMATION

If more than one screen,  
show locations of each on sketch.