

CODED

MISSISSIPPI
BOARD OF WATER COMMISSIONERS
416 North State Street
Jackson, Mississippi 39201

WATER WELL DRILLERS LOG

Prentiss
751
6-14-69

June 14 1969 J. W. Webb & son Prentiss
date well completed firm name county well located

LANDOWNER: William H

description of formations encountered

from to

Young RT. 2

Clay 0 15
Blue marl 15 100
Water sand 100 205
Blue marl 205 220

Boonville Miss
(mailing address)

WELL LOCATION:

sec 8 T 55 N R 7 E
S W
3 miles west of Boonville
(distance) (direction) (nearest town)

WELL PURPOSE: home
(home, irrigation, municipal, industrial)

WELL COMPLETION DATA:

- (1) diameter (inches) 5"
- (2) total depth (feet) 220'
- (3) static water level (feet) 80 below top of ground.
- (4) casing steel 21', (depth)

(size) if telescope see back.

- (5) screen none (length) (depth to top)

(size) (material)

- (6) pump 1 15 (HP) (yield gpm)

electric (type power)

- (7) electric log no (yes or no)

(organization running log)

- (8) how well bottom plugged


JUN 9 1969

DRILLERS REMARKS:

MISS. RD. OF
WATER CO.

If well telescopes please
sketch and show depths.

GROUND LEVEL

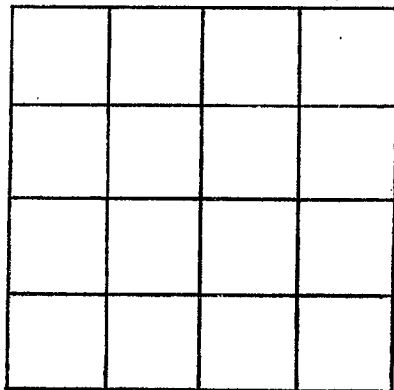

SECTION 8

Please indicate well location X.

ADDITIONAL INFORMATION

If more than one screen,
show locations of each on sketch.