

PRENTISS
 B53
 10-22-69

MISSISSIPPI
 BOARD OF WATER COMMISSIONERS
 416 North State Street
 Jackson, Mississippi 39201

CODED

WATER WELL DRILLERS LOG

Oct 22 1969 J. W. Welborn Prentiss
 date well completed firm name county well located

LANDOWNER: L. C. McArthur

description of formations encountered	from	to
---------------------------------------	------	----

Boonville
 (mailing address)

Soil	0	8
White Rock	8	20
Blue Rock	20	120
Water Sand	120	220
Caprock		

WELL LOCATION:

sec. 8 T. 58 N. R. 7 E.
 2 1/2 miles West of Boonville
 (distance) (direction) (nearest town)

WELL PURPOSE:
 (home, irrigation, municipal, industrial)

WELL COMPLETION DATA:

- (1) diameter (inches) 5
- (2) total depth (feet) 220
- (3) static water level (feet) 103 below top of ground.
- (4) casing Steel 22ft (material) (depth)
 5 (size) if telescope see back.
- (5) screen (length) (depth to top)
 (size) (material)
- (6) pump 1/2 HP 6 (HP) (yield gpm)
 Eder (type power)
- (7) electric log (yes or no)

(organization running log)

(8) how well bottom plugged


DRILLERS REMARKS:

DEC - 9 1969

MISS. BD. OF
 WATER COMMISSIONERS

If well telescopes please sketch and show depths.

GROUND LEVEL

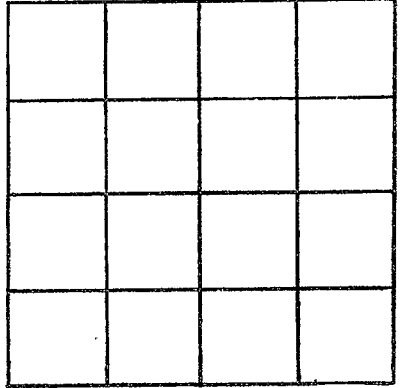

SECTION _____

Please indicate well location X.

ADDITIONAL INFORMATION

If more than one screen,
show locations of each on sketch.