

PRENTISS
 FS4
 8-25-70

MISSISSIPPI
 BOARD OF WATER COMMISSIONERS
 416 North State Street
 Jackson, Mississippi 39201

CODED

WATER WELL DRILLERS LOG

8-25-1970 date well completed
 Bonds Well Drilling firm name
 Prentiss county well located

LANDOWNER: Earl Miles

description of formations encountered	from	to

Brownville Miss
 (mailing address)

Red Clay	0	18
Blue Clay	18	60
Irregular Strata	60	90
Bluish Clay	90	190
Water sand	190	240

WELL LOCATION:
 sec. 7 T. 5 N R. 70 E
4 miles West of Brownville
 (distance) (direction) (nearest town)

WELL PURPOSE: Home
 (home, irrigation, municipal, industrial)

WELL COMPLETION DATA:

CODED

- (1) diameter (inches) 4
- (2) total depth (feet) 240
- (3) static water level (feet) 70 ~~below~~ ^{above} top of ground.
- (4) casing Steel 105
 (material) (depth)
 _____ if telescope see back.
 (size)
- (5) screen none
 (length) (depth to top)

 (size) (material)
- (6) pump 1 5
 (HP) (yield gpm)
Electric
 (type power)
- (7) electric log no
 (yes or no)


 (organization running log)
- (8) how well bottom plugged Open

DRILLERS REMARKS:

SEP 9 1970

If well telescopes please sketch and show depths.

GROUND LEVEL

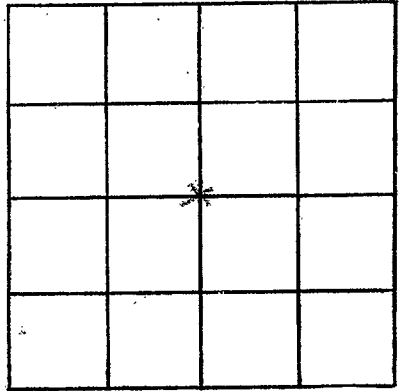

SECTION _____

Please indicate well location X.

ADDITIONAL INFORMATION

If more than one screen, show locations of each on sketch.