

Prentiss  
F55  
6-26-70

MISSISSIPPI  
BOARD OF WATER COMMISSIONERS  
416 North State Street  
Jackson, Mississippi 39201

**CODED**

WATER WELL DRILLERS LOG

6-26 1970 Bond Well Drilling Prentiss  
date well completed firm name county well located

LANDOWNER: Clide Mann

description of formations encountered from to

Barnwell Miss  
(mailing address)

Red clay 0 20  
Mixed sand 20 75  
Blue clay 75 152  
Water table 152 200

WELL LOCATION:  
sec. 33 T. 5 N. R. 7 E  
2 miles South of Barnwell  
(distance) (direction) (nearest town)

WELL PURPOSE: Home  
(home, irrigation, municipal, industrial)

WELL COMPLETION DATA:

**CODED**

- (1) diameter (inches) 4
- (2) total depth (feet) 200
- (3) static water level (feet) 80 below above top of ground.
- (4) casing Steel, 34  
(material) (depth)  
\_\_\_\_ if telescope see back.  
(size)
- (5) screen None  
(length) (depth to top)  
(size) (material)
- (6) pump 1 5  
(HP) (yield gpm)  
1/2  
(type power)
- (7) electric log no  
(yes or no)  
(organization running log)
- (8) how well bottom plugged open


JUL 7 1970

DRILLERS REMARKS:

MISS. BD. OF  
WATER COMM.

If well telescopes please sketch and show depths.

GROUND LEVEL

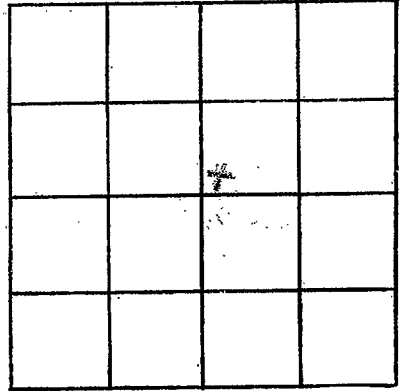

SECTION \_\_\_\_\_

Please indicate well location X.

ADDITIONAL INFORMATION

If more than one screen,  
show locations of each on sketch.