

PRENTISS

F56

8-13-70

MISSISSIPPI BOARD OF WATER COMMISSIONERS
416 North State Street
Jackson, Mississippi 39201

CODED

WATER WELL DRILLERS LOG

8-13 1970 Herndon-Homan, Inc. Prentiss
date well completed firm name county well located

LANDOWNER: Carmen Breedlove

description of formations encountered	from	to
Surface sand & clay	0	25
Blue clay	25	40
Sand	40	140
Bedrock	140	

Route 1
Booneville, Miss
(mailing address)

WELL LOCATION:

sec. 25 T. 5 N R. 7 E
S W
3 miles SE of Booneville
(distance) (direction) (nearest town)

WELL PURPOSE: Home
(home, irrigation, municipal, industrial)

WELL COMPLETION DATA:

- (1) diameter (inches) 5"
- (2) total depth (feet) 140'
- (3) static water level (feet) 80 below top of ground.
- (4) casing Steel 29'3"
(material) (depth)
5' if telescope see back.
(size)
- (5) screen 70 (length) (depth to top)
(size) (material)
- (6) pump (HP) (yield gpm)
(type power)
- (7) electric log NO (yes or no)
(organization running log)
- (8) how well bottom plugged open

CODED


OCT 12 1970

DRILLERS REMARKS:

MISS. Bd. OF WATER COMMISSIONERS

If well telescopes please sketch and show depths.

GROUND LEVEL

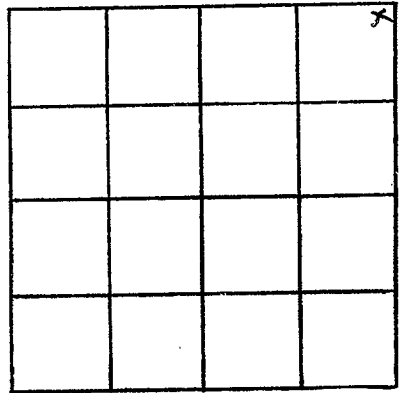

SECTION 25

Please indicate well location X.

ADDITIONAL INFORMATION

If more than one screen,
show locations of each on sketch.