

PRENTISS
F57
11-13-70

MISSISSIPPI
BOARD OF WATER COMMISSIONERS
416 North State Street
Jackson, Mississippi 39201

CODED

WATER WELL DRILLERS LOG

11-13 1970 Bonds Well Drilling, Prentiss
date well completed firm name county well located

LANDOWNER: Max J. Harris
Boonville, Miss
(mailing address)

description of formations encountered	from	to
Red clay	0	32
Blue clay	32	63
Red Red sand	63	118
Blue clay	118	305
Water sand	305	360

WELL LOCATION:
sec. 23 T. 5 N R. 7 E
3 miles East of Boonville
(distance) (direction) (nearest town)

WELL PURPOSE: Home
(home, irrigation, municipal, industrial)

- WELL COMPLETION DATA:
- (1) diameter (inches) 4
 - (2) total depth (feet) 360
 - (3) static water level (feet) 160 below top of ground.
 - (4) casing Steel, 126,
(material) (depth)
_____ if telescope see back.
(size)
 - (5) screen none
(length) (depth to top)
_____ (size) _____ (material)
 - (6) pump 2 4 1/2
(HP) (yield gpm)
Elect
(type power)
 - (7) electric log no
(yes or no)
_____ (organization running log)
 - (8) how well bottom plugged open

CODED


DEC 7 1970

DRILLERS REMARKS:

MISS. BD. OF
WATER COMML.

If well telescopes please sketch and show depths.

GROUND LEVEL

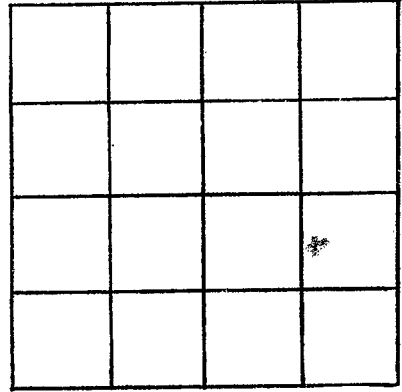

SECTION _____

Please indicate well location X.

ADDITIONAL INFORMATION

If more than one screen, show locations of each on sketch.