

PRENTISS

F63

11/15/84

MISSISSIPPI

BOARD OF WATER COMMISSIONERS

416 North State Street

Jackson, Mississippi 39201

CODED

WATER WELL DRILLERS LOG

NOV

date well completed

Leeper Drilling

firm name

Prentiss

county well located

LANDOWNER: H & W Industries

Prentiss Co. Industrial Park

Brownville, MS

(mailing address)

description of formations encountered

from

to

Top Red Sand

0

30

Blue clay

30

80

Silty clay

80

140

Green Sand

140

220

Silty clay

220

300

Fine Sand

300

415

Gravel (CODED)

415

477

Gravel and clay

477

520

Eqw. 490'

(NE SE S3)

WELL LOCATION:

NESE sec 3 T 5 N R 7 E

Same as above (distance) (direction) (nearest town)

WELL PURPOSE:

(home, irrigation, municipal (industrial))

WELL COMPLETION DATA:

- (1) diameter (inches) 10"
(2) total depth (feet) 477
(3) static water level (feet) 180 below above top of ground.
(4) casing Steel 358' (material) (depth) 10" (size) If telescope see back.
(5) screen 40' 437' (length) (depth to top) 6" Stainless Steel (size) (material)
(6) pump 60 450 (HP) (yield gpm) 30 (type power)
(7) electric log No (yes or no)
(organization running log)

(organization running log)

(8) how well bottom plugged

DRILLERS REMARKS:

I do not have a Prentiss Co. Map for section, township, etc.

DEPT. OF NATURAL RESOURCES BUREAU OF LAND & WATER RESOURCES

NOV 29 1984

RECEIVED



If well telescopes please sketch and show depths.

GROUND LEVEL

STUB
180 ft


6" Cap. Pipe

to 308'

GRout →

10" steel casing to 358'

← 16" →

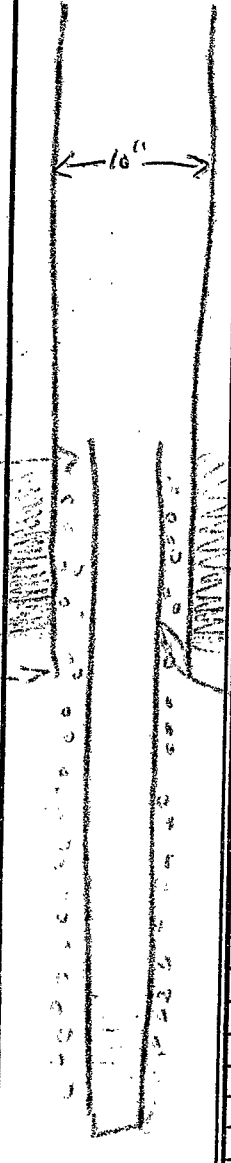

| | | | |
|--|--|--|--|
| | | | |
| | | | |
| | | | |
| | | | |

SECTION _____

Please indicate well location X.

ADDITIONAL INFORMATION

GRout from 312 ft to 358'

Well No.

427

1. 977

If more than one screen, show locations of each on sketch.