

PRE MISS MISSISSIPPI BOARD OF WATER COMMISSIONERS

F 2003

10-23-62

WATER WELL DRILLERS LOG

Date: Feb 23, 1962, Driller: HERNDON WELL & SUPPLY CO County Prentiss

P.O. BOX 42
SHANNON, MISSISSIPPI


(1) Owner of Land:	Description & Color of Materials Sand, Clay, Red Clay, Shell, etc.	Thick- ness Feet	Depth Feet
(Name) <u>Mrs Greas</u> (Address) <u>Boonville, Miss.</u>	<u>super sand</u> <u>& clay</u>		<u>0</u>
(2) Location: <u>1/4, 1/4, Sec. 4 T. 25 R. 18 E.</u> <u>3</u> miles <u>W</u> of <u>Boonville</u> (distance) (direction) (Nearest Town)	<u>blue mark</u> <u>7</u> <u>sand</u>		<u>18</u> <u>50</u>
(3) Topography: <u>Flat</u> (Hilly) (Flat) (Level)	<u>7</u>		
(4) Purpose of Well: <u>Domestic</u> (Domestic Irrigation Municipal, Industrial, Other)	<u>Bottom</u>		<u>200</u>

Information upon completion of well:

- (1) Diameter 4 inches.
- (2) Total Depth 200 feet.
- (3) Water Level 70 feet below top of ground.
- (4) Cased to 20 ft, Size 4 in
- (5) Screen: Size —, Length —
- (6) Were any formations sealed against pollution?
 yes, no.

If YES depth of formation 18 ft.
 Why super & sand

Drillers Remarks:

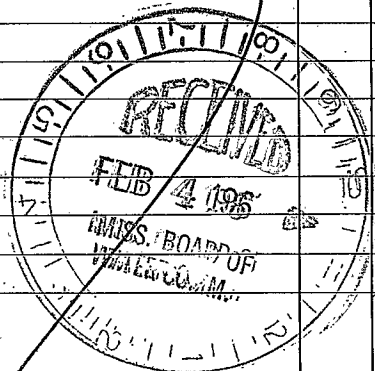

(Use Back Side)

Well No.

