

PRENTISS MISSISSIPPI BOARD OF WATER COMMISSIONERS

F 2004

10-24-62

WATER WELL DRILLERS LOG

HERNDON WELL & SUPPLY CO.

Date: Oct 24, 1962, Driller: P O BOX 42 County Prentiss

SHANNON, MISSISSIPPI

(1) Owner of Land:	Description & Color of Materials Sand, Clay, Red Clay, Shell, etc.	Thick- ness Feet	Depth Feet
<u>Edna Cooper</u> (Name)	<u>Surface sand</u> <u>& clay</u>		<u>0</u>
<u>At 3 Reizi, Miss</u> (Address)	<u>Blue rock</u>		<u>16</u>
(2) Location: <u>1/4</u> , <u>1/4</u> , Sec. <u>33</u> <u>53</u> <u>R7E</u>	<u>sand</u>		<u>30</u>
<u>2</u> miles <u>W</u> , of <u>Reizi</u> , (distance) (direction) (Nearest Town)	<u>Water</u>		<u>200</u>
(3) Topography: <u>Flat</u> (Hilly) (Flat) (Level)			
(4) Purpose of Well: <u>Domestic</u> (Domestic Irrigation Municipal, Industrial, Other)			


Information upon completion of well:

- (1) Diameter 4 inches.
- (2) Total Depth 200 feet.
- (3) Water Level 40 feet below top of ground.
- (4) Cased to 21 ft, Size 4 in.
- (5) Screen: Size , Length .
- (6) Were any formations sealed against pollution?
 yes, no.

If YES depth of formation 16

Why Surface & sand

Drillers Remarks:

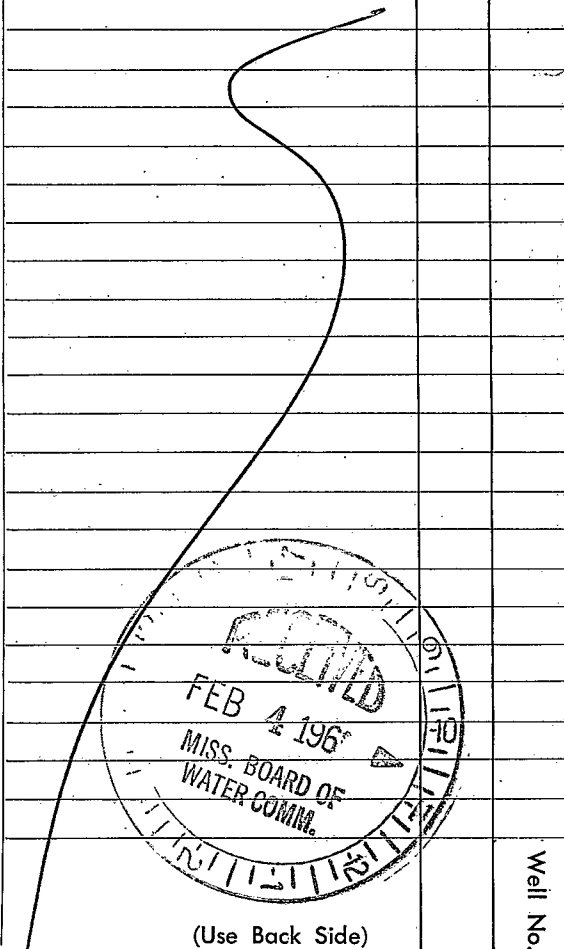

(Use Back Side)

Well No.

