

PRENTISS

F 2005

4-4-63

WATER WELL DRILLERS LOG

HERNDON WELL & SUPPLY CO.

Date: April 4, 1963, Driller: P.O. BOX 42 County Prentiss
SHANNON (Name) MISSISSIPPI

(1) Owner of Land:	Description & Color of Materials Sand, Clay, Red Clay, Shell, etc.	Thick- ness Feet	Depth Feet
(Name) <u>W.A. Braddens</u> (Address) <u>Brownville, Miss.</u>	<u>surface sand</u> <u>& clay</u>		<u>0</u>
(2) Location: <u>1/4</u> , <u>1/4</u> , Sec. <u>24</u> , T. <u>5S</u> , R. <u>7E</u> <u>3 1/2</u> miles <u>SE</u> , of <u>Brownville</u> (distance) (direction) (Nearest Town)	<u>Blue rock</u> <u>to</u>		<u>36</u>
(3) Topography: <u>Hilly</u> (Hilly) (Flat) (Level)	<u>sand</u>		<u>100</u>
(4) Purpose of Well: <u>Domestic</u> (Domestic Irrigation Municipal, Industrial, Other)	<u>to</u>		<u>Bottom 220</u>


Information upon completion of well:

- (1) Diameter 4 inches.
- (2) Total Depth 220 feet.
- (3) Water Level 70 feet below top of ground.
- (4) Cased to 40', Size 4"
- (5) Screen: Size —, Length —
- (6) Were any formations sealed against pollution?
 yes, no.

If YES depth of formation 36'

Why surface & sand

Drillers Remarks:

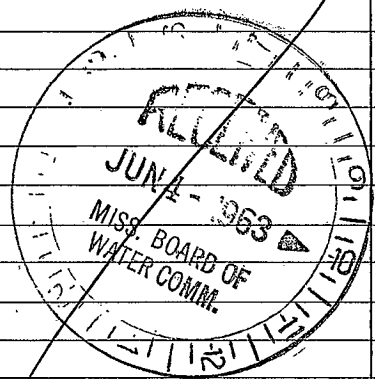

(Use Back Side)

Well No.

