

Orentiss
 72009
 8-15-68

MISSISSIPPI
 BOARD OF WATER COMMISSIONERS
 416 North State Street
 Jackson, Mississippi 39201

WATER WELL DRILLERS LOG

August 15 1968 Bonds Grenliss
 date well completed firm name county well located

LANDOWNER: Patton Mills
 Rt 4
 Booneville Miss
 (mailing address)

WELL LOCATION:
 sec 34 T 5 N R 7 E
 3 miles South of Booneville
 (distance) (direction) (nearest town)

description of formations encountered	from	to
Sandy loam	0	10
Sand & clay	10	38
Blue Clay (Sandy)	38	76
Sand in streaks	76	102
Blue clay	102	145
Water Sand	145	200

WELL PURPOSE: Home
 (home, irrigation, municipal, industrial)

WELL COMPLETION DATA:

(1) diameter (inches) 4"

(2) total depth (feet) 200'

(3) static water level (feet) Not known below top of ground.


(4) casing Steel 105'
 4" (material) (depth)
 No if telescope see back...
 (size)

(5) screen none
 (length) (depth to top)
 none (size) (material)

(6) pump installed down pump
 (HP) (yield gpm)
 Elect (type power)

(7) electric log no
 (yes or no)
 none (organization running log)


(8) how well bottom plugged Open

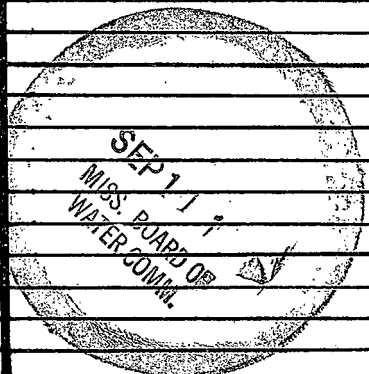

DRILLERS REMARKS: -

If well telescopes please sketch and show depths.

GROUND LEVEL

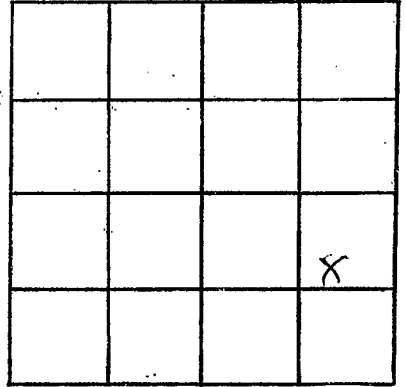

SECTION 30

Please indicate well location X.

ADDITIONAL INFORMATION

If more than one screen, show locations of each on sketch.