

Prentiss  
 72010  
 9-24-68

MISSISSIPPI  
 BOARD OF WATER COMMISSIONERS  
 416 North State Street  
 Jackson, Mississippi 39201

WATER WELL DRILLERS LOG

Sept 24 1968 Bonds Prentiss  
 date well completed firm name county well located

LANDOWNER: Arnold Halford  
 Rt 4  
 Booneville Miss (mailing address)  
 description of formations encountered  
 Sandy clay  
 Blue clay  
 Blue clay  
 water sand mud  
 from to  
 0 30  
 30 76  
 76 105  
 105 225

WELL LOCATION:  
 sec. 28 T. 5 N R. 7 E  
 3 1/4 miles S.W. of Booneville  
 (distance) (direction) (nearest town)

WELL PURPOSE: Home  
 (home, irrigation, municipal, industrial)

WELL COMPLETION DATA:  
 (1) diameter (inches) 4  
 (2) total depth (feet) 225  
 (3) static water level (feet) 74 below top of ground.  
 (4) casing Steel 80 (material) (depth)  
 4" (size) if telescope see back.  
 (5) screen none (length) (depth to top)


(6) pump He had his pump (size) (material) (HP) (yield gpm)  
 Elect (type power)

(7) electric log (yes or no)

(organization running log)

(8) how well bottom plugged Open

DRILLERS REMARKS:

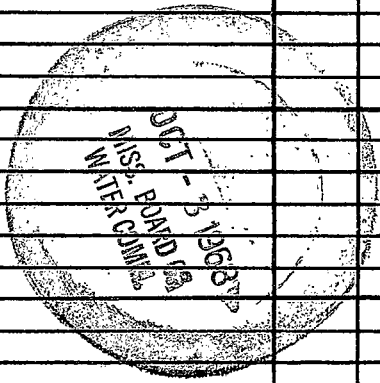

If well telescopes please sketch and show depths.

GROUND LEVEL

X			

SECTION 28

Please indicate well location X.

ADDITIONAL INFORMATION

If more than one screen,  
show locations of each on sketch.