

PRENTISS

F 2011

3-29-77

MISSISSIPPI BOARD OF WATER COMMISSIONERS 416 North State Street Jackson, Mississippi 39201

WATER WELL DRILLERS LOG

3-29 1977 Bomb Well Drilling Prentiss date well completed firm name county well located

LANDOWNER: Island Owens

description of formations encountered

from to

Bonneville

Red Clay

0 10

Yellow Sand

10 70

Blue Clay

70 280

Water Sand

280 340

(mailing address)

WELL LOCATION:

sec 33 T 5 N R 7 E

3 miles S of Bonneville (distance) (direction) (nearest town)

WELL PURPOSE: Home (home, irrigation, municipal, industrial)

WELL COMPLETION DATA:

- (1) diameter (inches) 4"
(2) total depth (feet) 340'
(3) static water level (feet) 160 below top of ground.
(4) casing Plastic, 80' (material) (depth)

(size) if telescope see back.

- (5) screen no (length) (depth to top)

(size) (material)

- (6) pump 3/4 10 gpm (HP) (yield gpm)

elect (type power)

- (7) electric log no (yes or no)

(organization running log)

- (8) how well bottom plugged open


DRILLERS REMARKS:

RECEIVED DEC - 7 1978

MISS. BD. OF WATER COMM

If well telescopes please sketch and show depths.

GROUND LEVEL

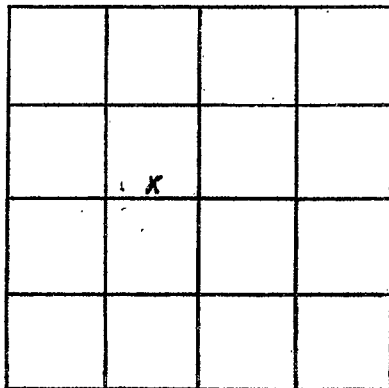

SECTION _____

Please indicate well location X.

ADDITIONAL INFORMATION

If more than one screen,
show locations of each on sketch.