

PRENTISS

F 2012

6-23-77

MISSISSIPPI BOARD OF WATER COMMISSIONERS
416 North State Street
Jackson, Mississippi 39201

WATER WELL DRILLERS LOG

6-23 1977
date well completed

Borch Well Drilling
firm name

Prentiss
county well located

LANDOWNER: Buster Young

Booneville

(mailing address)

WELL LOCATION:

sec. 6 T. 5 N R. 7 E

4 miles W of Booneville
(distance) (direction) (nearest town)

WELL PURPOSE: Home
(home, irrigation, municipal, industrial)

WELL COMPLETION DATA:

- (1) diameter (inches) 4"
- (2) total depth (feet) 215
- (3) static water level (feet) 100 ^{below} ~~above~~ top of ground.

(4) casing Plastic, 120
(material) (depth)

_____ if telescope see back.
(size)

(5) screen no
(length) (depth to top)

(size) (material)

(6) pump 3/4 10 gpm
(HP) (yield gpm)

elect.
(type power)

(7) electric log no
(yes or no)

(organization running log)

(8) how well bottom plugged open

description of formations encountered

from

to

Red Clay	0	20
Yellow Sand	20	110
Blue Clay	110	150
Water Sand	150	215

DRILLERS REMARKS:


RECEIVED

DEC - 5 1978

MISS. Bd. OF WATER COMM.

If well telescopes please sketch and show depths.

GROUND LEVEL

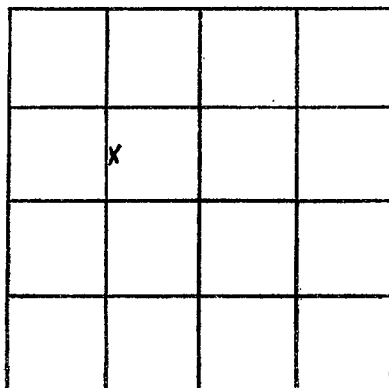

SECTION _____

Please indicate well location X.

ADDITIONAL INFORMATION

If more than one screen, show locations of each on sketch.