

MISSISSIPPI BOARD OF WATER COMMISSIONERS

Prentiss

6  
9-66

WATER WELL DRILLERS LOG

Date: Sept 20, 1966, Driller: BONDS PLUMBING & DRILLING CO County: Prentiss  
(Name)

		Description & Color of Materials Sand, Clay, Red Clay, Shell, etc.	Thick- ness Feet	Depth Feet
(1) Owner of Land:	<u>Helen Hifford</u> (Name)	<u>Red Clay</u>	<u>40</u>	
	<u>Boonerville, Miss</u> (Address)	<u>Sandy blue</u>	<u>60</u>	
		<u>water sand</u>	<u>50</u>	<u>150</u>
(2) Location:	<u>NE 1/4</u> , _____ <u>1/4</u> , Sec. _____ T. _____ R. _____ <u>5</u> miles <u>East</u> , of <u>Boonerville</u> (distance) (direction) (Nearest Town)			
(3) Topography:	<u>Hilly</u> (Hilly) (Flat) (Level)			
(4) Purpose of Well:	<u>Domestic</u> (Domestic Irrigation Municipal, Industrial, Other)			


Information upon completion of well:

- (1) Diameter 4 inches.
- (2) Total Depth 150 feet.
- (3) Water Level 50 feet below top of ground.
- (4) Cased to 42, Size 4
- (5) Screen: Size \_\_\_\_\_, Length \_\_\_\_\_
- (6) Were any formations sealed against pollution?  
\_\_\_\_\_ yes, \_\_\_\_\_ no.

If YES depth of formation \_\_\_\_\_

Why \_\_\_\_\_

Drillers Remarks: \_\_\_\_\_

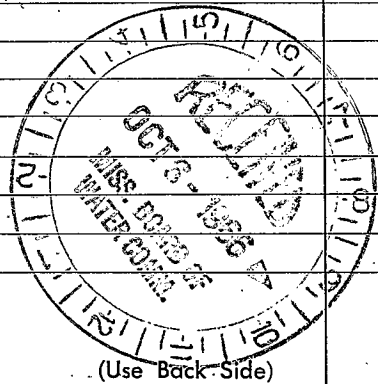

(Use Back Side)

Well No.

Retain this copy for your office files.

# THE UNIVERSITY OF CHICAGO

PHILOSOPHY DEPARTMENT

PHILOSOPHY 101

LECTURE NOTES

PROFESSOR [Name]

WINTER 2023

LECTURE 1

THE PHILosophical

TRADITION

AND ITS

FOUNDATIONS

IN THE

WESTERN

TRADITION

AND ITS

FOUNDATIONS

IN THE

WESTERN

TRADITION

AND ITS

FOUNDATIONS

IN THE

WESTERN

TRADITION

AND ITS

FOUNDATIONS

IN THE

WESTERN

TRADITION

AND ITS